
ABELL SURVEYING & MAPPING DELAVAN, WISCONSIN 53115 414-728-6737

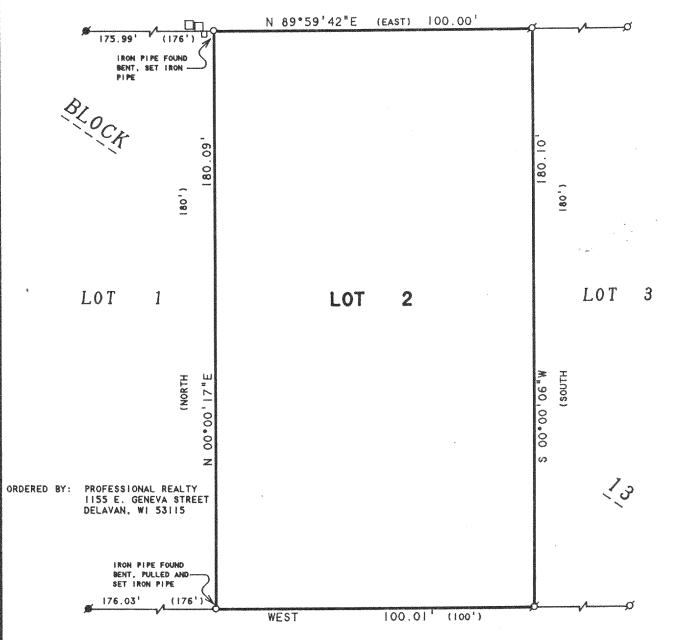

VALENCIA PLACE

NOTE: BEARINGS ARE REFERENCED TO THE RECORDED SUBDIVISION PLAT.

PLAT OF SURVEY OF

LOT 2. BLOCK13. INLET OAKS SUBDIVISION NO. 5. LOCATED IN T2N, RIGE, WALWORTH COUNTY, WISCONSIN.

I HEREBY CERTIFY THAT I HAVE SURVEYED THE ABOVE DESCRIBED PROPERTY AND THAT THE ABOVE MAP IS A TRUE REPRESENTATION THEREOF AND SHOWS THE SIZE AND LOCATION OF THE PROPERTY, ITS EXTERIOR BOUNDARIES. THE LOCATION OF ALL VISIBLE STRUCTURES AND DIMENSIONS OF ALL PRINCIPAL BUILDINGS THEREON, BOUNDARY FENCES. APPARENT EASEMENTS, ROADWAYS AND VISIBLE ENCROACHMENTS, IF ANY, TO THE BEST OF MY KNOWLEDGE AND BELIEF.



THIS SURVEY IS MADE FOR THE USE OF THE PRESENT OWNERS OF THE PROPERTY. AND ALSO THOSE WHO PURCHASE. MORTGAGE, OR GUARANTEE THE TITLE THERETO WITHIN ONE (1) YEAR FROM DATE HEREON.

SCALE | "=30"

brid D. F. ABF' DAVID F. ABELL WISCONSIN REGISTERED LAND SURVEYOR. S-1596

160 - 5 1996

LEGEND

Ø -IRON PIPE FOUND ■ -IRON ROD FOUND O -IRON PIPE SET DO -UTILITY PEDS.

)-RECORDED AS

September 30, 1996

DATE DOTE: THIS IS NOT A CERTIFIED COPY UNLESS SEALED.