


**ABELL
SURVEYING & MAPPING
DELANAV, WISCONSIN 53115
414-728-6737**

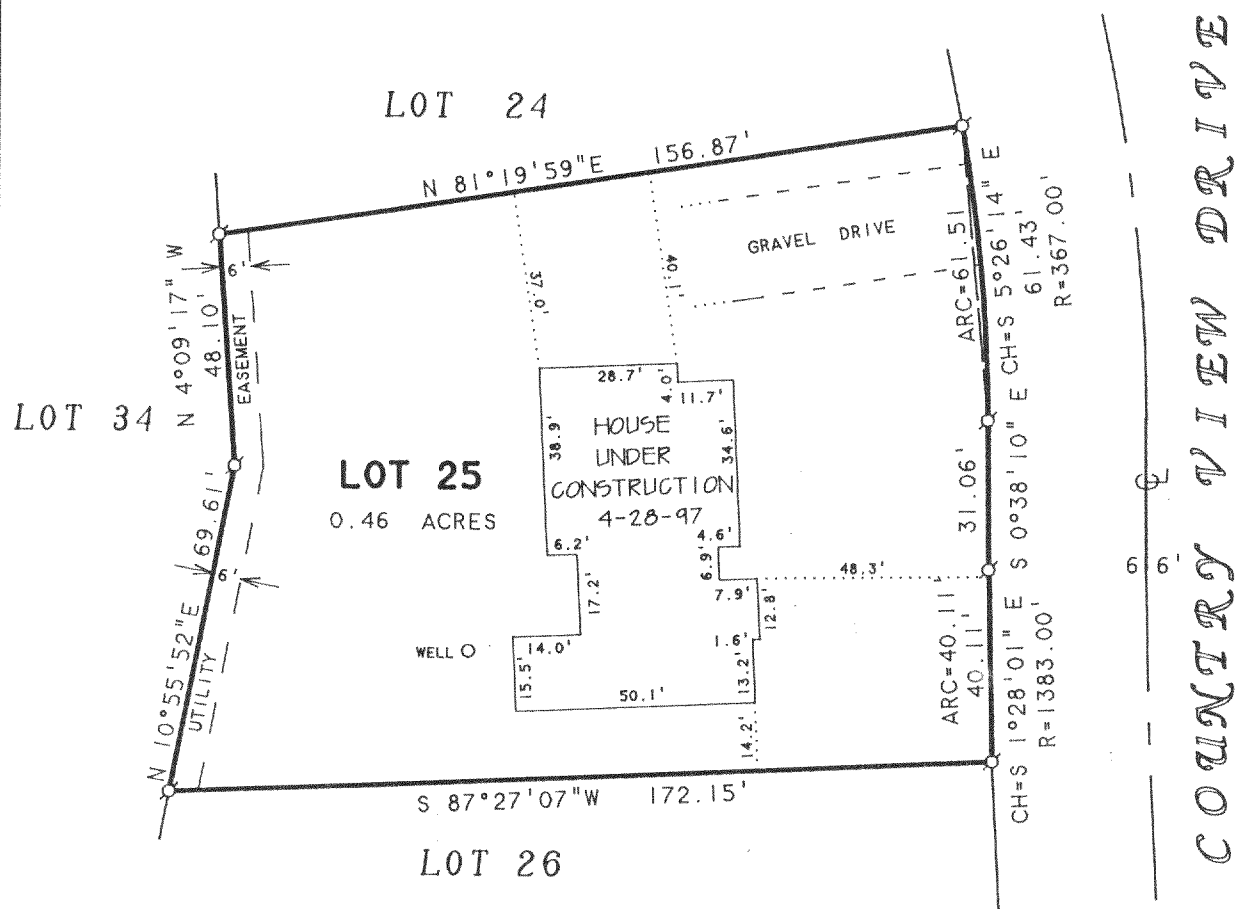


NOTE: BEARINGS ARE REFERENCED TO THE RECORDED SUBDIVISION PLAT.

PLAT OF SURVEY OF

LOT 25, COUNTRY VIEW SUBDIVISION, T2N, R16E,
WALWORTH COUNTY, WISCONSIN

ORDERED BY: PROFESSIONAL REALTY
1155 E. GENEVA STREET
DELANAV, WI 53115

REVISED DATE: JANUARY 22, 1997
REVISED TO SHOW PROPOSED HOUSE
LOCATION.

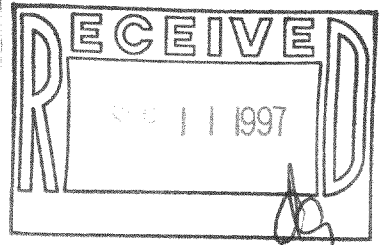

REVISED DATE: APRIL 29, 1997
REVISED TO SHOW HOUSE UNDER
CONSTRUCTION.

ORDERED BY: STERNITZ BUILDERS
P.O. BOX 526
DELANAV, WI 53115



SCALE 1" = 40'

LEGEND

⊙ - IRON PIPE FOUND

I HEREBY CERTIFY THAT I HAVE SURVEYED THE ABOVE DESCRIBED PROPERTY AND THAT THE ABOVE MAP IS A TRUE REPRESENTATION THEREOF AND SHOWS THE SIZE AND LOCATION OF THE PROPERTY, ITS EXTERIOR BOUNDARIES, THE LOCATION OF ALL VISIBLE STRUCTURES AND DIMENSIONS OF ALL PRINCIPAL BUILDINGS THEREON, BOUNDARY FENCES, APPARENT EASEMENTS, ROADWAYS AND VISIBLE ENCROACHMENTS, IF ANY, TO THE BEST OF MY KNOWLEDGE AND BELIEF.

THIS SURVEY IS MADE FOR THE USE OF THE PRESENT OWNERS OF THE PROPERTY, AND ALSO THOSE WHO PURCHASE, MORTGAGE, OR GUARANTEE THE TITLE THERETO WITHIN ONE (1) YEAR FROM DATE HEREON.

David F. Abell
DAVID F. ABELL
WISCONSIN REGISTERED LAND SURVEYOR, S-1596

December 18, 1996

DATE: _____ JOB NUMBER - 96217
NOTE: THIS IS NOT A CERTIFIED COPY UNLESS SEALED.

FCV-25 216-2397