


ABELL SURVEYING & MAPPING

1140 SEQUOIA STREET • DELAVAN, WISCONSIN 53115
414-728-6737

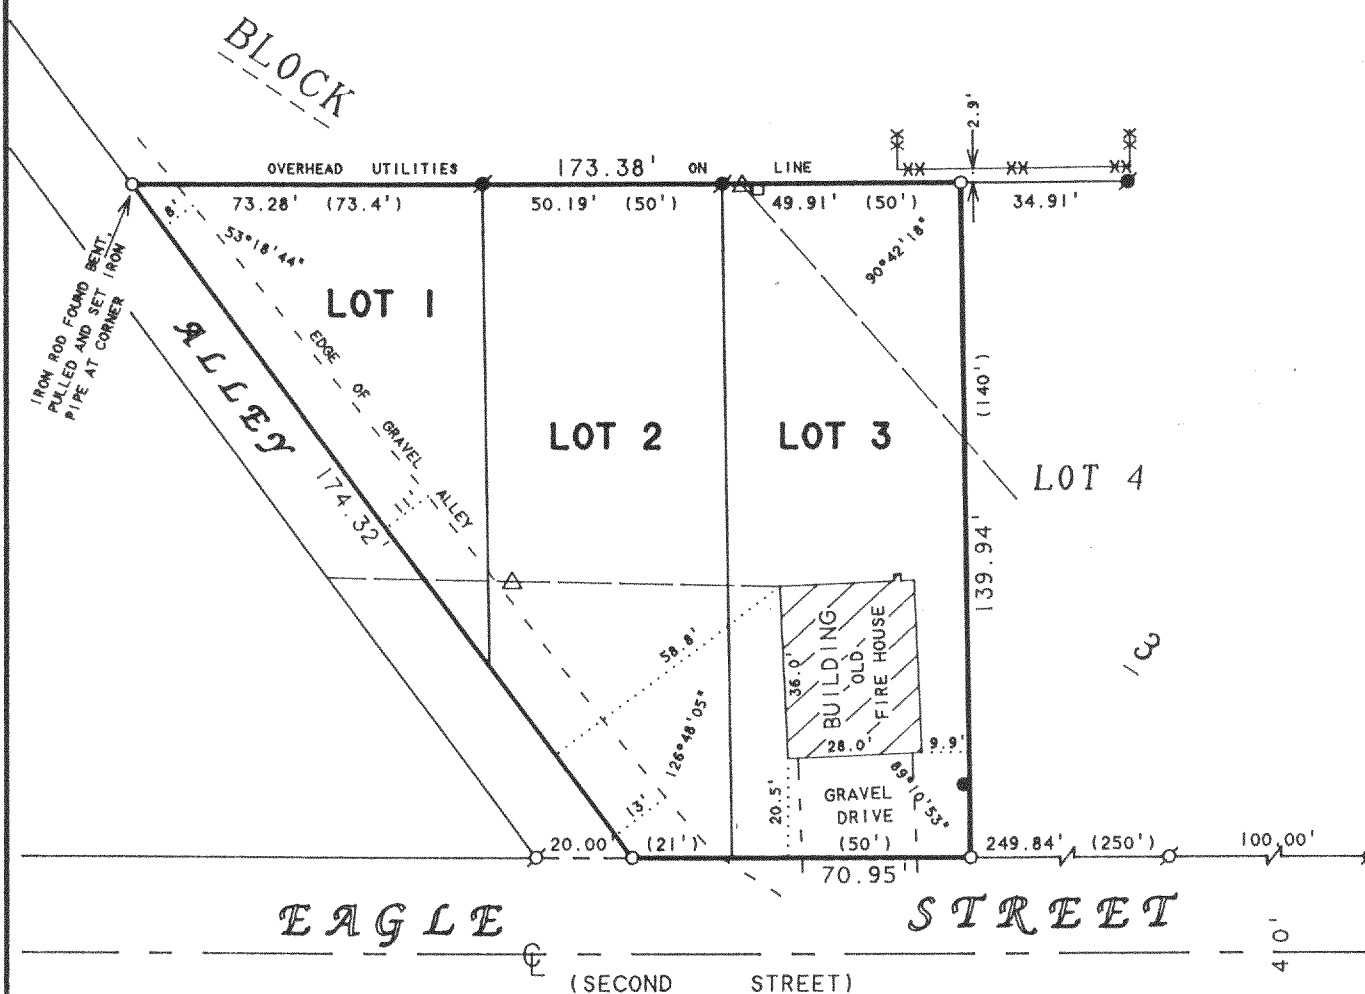

ORDERED BY: BILL MULARKEY
420 NEGLEY AVENUE
DELAVAN, WI 53115
FOR: INLET OAKS OWNERS ASSOCIATION

PLAT OF SURVEY OF

LOTS 1-3, BLOCK 3, INLET OAKS SUBDIVISION NO. 3,
LOCATED IN T2N, R16E, WALWORTH COUNTY, WISCONSIN.


N



SCALE 1" = 40'

LEGEND

- - IRON PIPE FOUND
- - IRON ROD FOUND
- - IRON PIPE SET
- - PVC PIPE
- △ - UTILITY POLE
- - OVERHEAD UTILITY LINES
- - UTILITY PED.
- XX - WIRE FENCE
- () - RECORDED AS

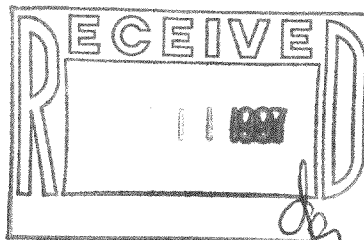

I HEREBY CERTIFY THAT I HAVE SURVEYED THE ABOVE DESCRIBED PROPERTY AND THAT THE ABOVE MAP IS A TRUE REPRESENTATION THEREOF AND SHOWS THE SIZE AND LOCATION OF THE PROPERTY, ITS EXTERIOR BOUNDARIES, THE LOCATION OF ALL VISIBLE STRUCTURES AND DIMENSIONS OF ALL PRINCIPAL BUILDINGS THEREON, BOUNDARY FENCES, APPARENT EASEMENTS, ROADWAYS AND VISIBLE ENCROACHMENTS, IF ANY, TO THE BEST OF MY KNOWLEDGE AND BELIEF.

THIS SURVEY IS MADE FOR THE USE OF THE PRESENT OWNERS OF THE PROPERTY, AND ALSO THOSE WHO PURCHASE, MORTGAGE, OR GUARANTEE THE TITLE THERETO WITHIN ONE (1) YEAR FROM DATE HEREON.

David F. Abell
DAVID F. ABELL
WISCONSIN REGISTERED LAND SURVEYOR, S-1596

August 15, 1997
DATE: August 15, 1997 JOB NUMBER - 97161
NOTE: THIS IS NOT A CERTIFIED COPY UNLESS SEALED.

FIN3-54 216-2415