


ABELL
SURVEYING & MAPPING

1140 SEQUOIA STREET • DELAVAN, WISCONSIN 53115
414-728-6737

NOTE 2: THE CENTERLINE OF THE CREEK
IS AS SHOWN ON CERTIFIED SURVEY
NO. 2029.

NOTE 1: BEARINGS ARE REFERENCED TO
CERTIFIED SURVEY NO. 2029.

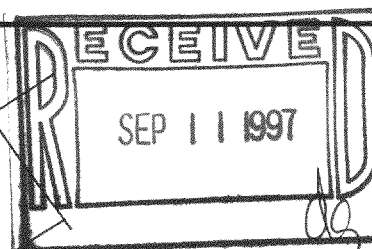

I HEREBY CERTIFY THAT I HAVE SURVEYED THE ABOVE DESCRIBED PROPERTY AND THAT THE ABOVE MAP IS A TRUE REPRESENTATION THEREOF AND SHOWS THE SIZE AND LOCATION OF THE PROPERTY, ITS EXTERIOR BOUNDARIES, THE LOCATION OF ALL VISIBLE STRUCTURES AND DIMENSIONS OF ALL PRINCIPAL BUILDINGS THEREON, BOUNDARY FENCES, APPARENT EASEMENTS, ROADWAYS AND VISIBLE ENCROACHMENTS, IF ANY, TO THE BEST OF MY KNOWLEDGE AND BELIEF.

THIS SURVEY IS MADE FOR THE USE OF THE PRESENT OWNERS OF THE PROPERTY, AND ALSO THOSE WHO PURCHASE, MORTGAGE, OR GUARANTEE THE TITLE THERETO WITHIN ONE (1) YEAR FROM DATE HEREON.

David F. Abell

DAVID F. ABELL
WISCONSIN REGISTERED LAND SURVEYOR, S-1596

July 23, 1997

DATE: _____ JOB NUMBER - 96201
NOTE: THIS IS NOT A CERTIFIED COPY UNLESS SEALED.

PLAT OF SURVEY OF

LOT 1, CERTIFIED SURVEY NO. 2029, LOCATED IN THE
SOUTHEAST 1/4 OF SECTION 32, T2N, R16E, WALWORTH
COUNTY, WISCONSIN, EXCEPTING THEREFROM THAT PART
AS RECORDED IN VOLUME 648 ON PAGES 4416 AND 4417,
AS DOCUMENT NO. 359397.

N



SCALE 1"=50'

LEGEND

- ⊙ - IRON PIPE FOUND
- - CONCRETE MONUMENT FOUND
- CS - CONCRETE STOOP
- * - WIRE FENCE
- () - RECORDED AS

ORDERED BY: CURTIS A. WOLF
2411 S. WENTWORTH AVE.
MILWAUKEE, WI 53207

FINCH LANE
(HOAG LANE)

SOUTH SHORE DRIVE

CERTIFIED

LOT

AREA 1.62 ACRES

LOT

NO.

HOUSE

GRAVEL DRIVE

CONCRETE GARAGE

CONCRETE

BLOCK PATIO

METAL COVER

SHED

FENCE 0.3' NORTH OF LINE

FENCE CORNER 0.2' WEST AND 0.6' NORTH OF LINE

FA-2029-1
216-2417