


ABELL
SURVEYING & MAPPING
DELAVAN, WISCONSIN 53115
414-728-6737

VALENCIA DRIVE

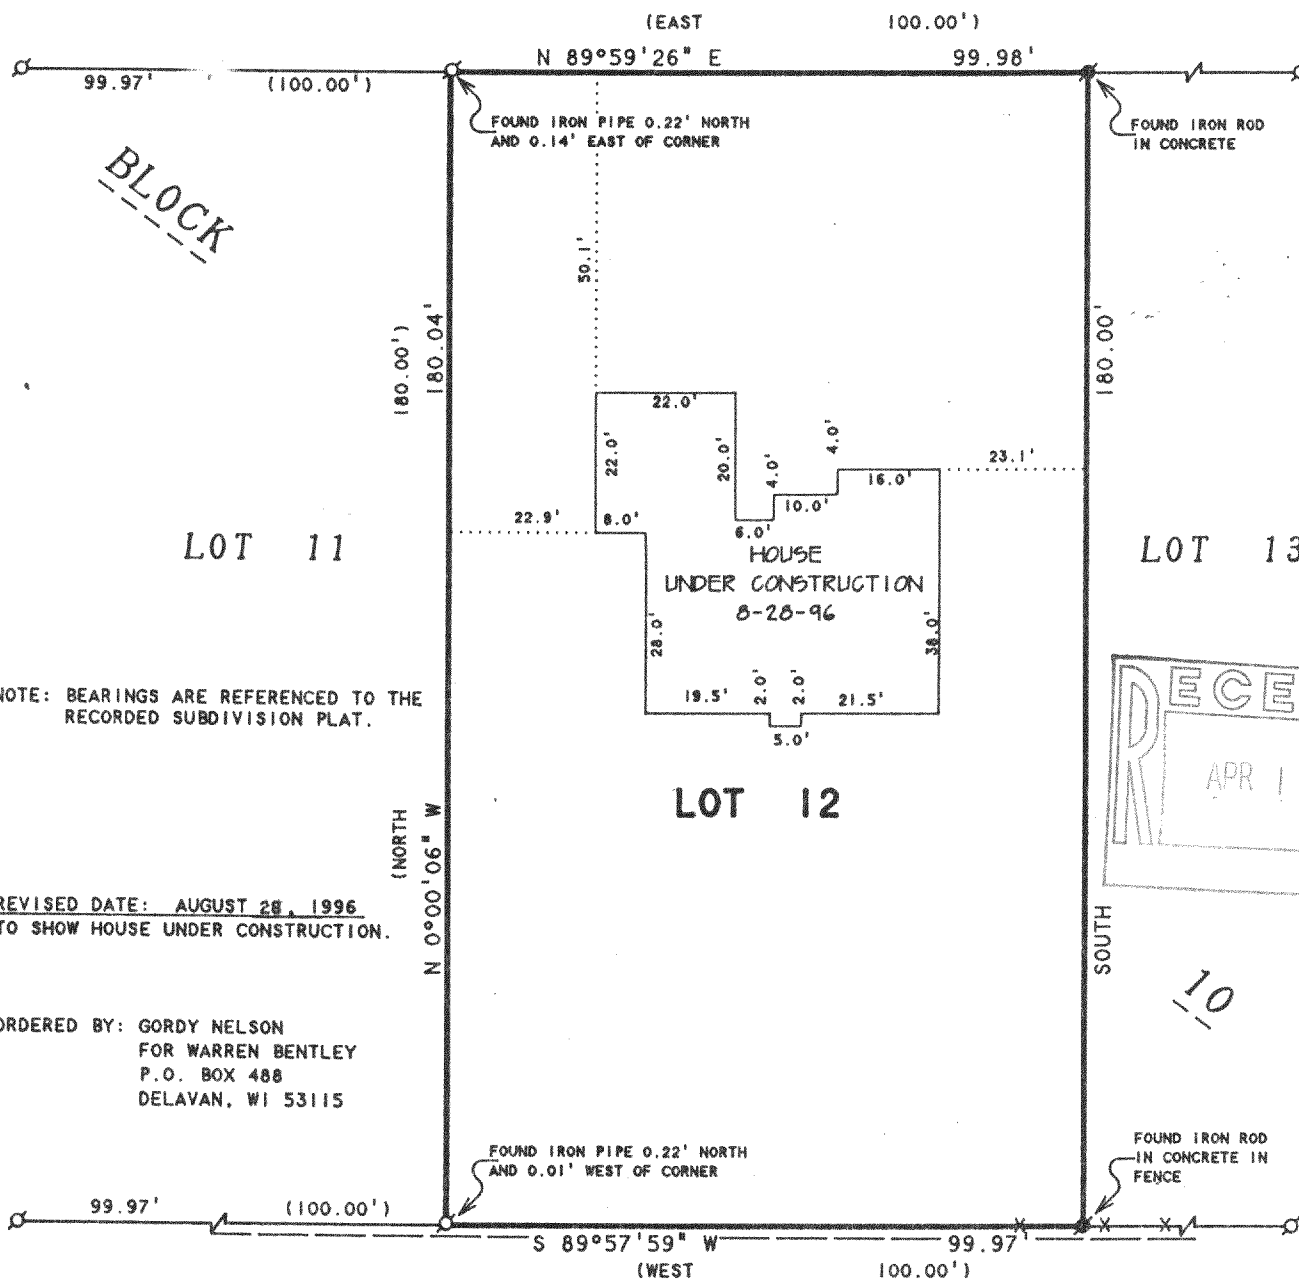

PLAT OF SURVEY OF

LOT 12, BLOCK 10, INLET OAKS SUBDIVISION NO. 5.
LOCATED IN T2N, R16E, WALWORTH COUNTY, WISCONSIN.

N



SCALE 1"=30'

LEGEND

- -IRON PIPE FOUND
- -IRON ROD IN CONCRETE FOUND
- -OVERHEAD UTILITY LINES
- × -WIRE FENCE
- () -RECORDED AS

I, DAVID F. ABELL, DO HEREBY CERTIFY THAT I HAVE SURVEYED THE PROPERTY HEREON DESCRIBED ACCORDING TO THE OFFICIAL RECORDS AND THAT THE PLAT HEREON IS A CORRECT REPRESENTATION OF THE PROPERTY LINES TO THE BEST OF MY KNOWLEDGE AND BELIEF.

David F. Abell

DAVID F. ABELL
WISCONSIN REGISTERED LAND SURVEYOR, S-1596

July 12, 1996

DATE: July 12, 1996 JOB NUMBER - 96102
NOTE: THIS IS NOT A CERTIFIED COPY UNLESS SEALED.