
## GEORGE T. DUNHAM SURVEYING & SUBDIVIDING DELAVAN, WISCONSIN

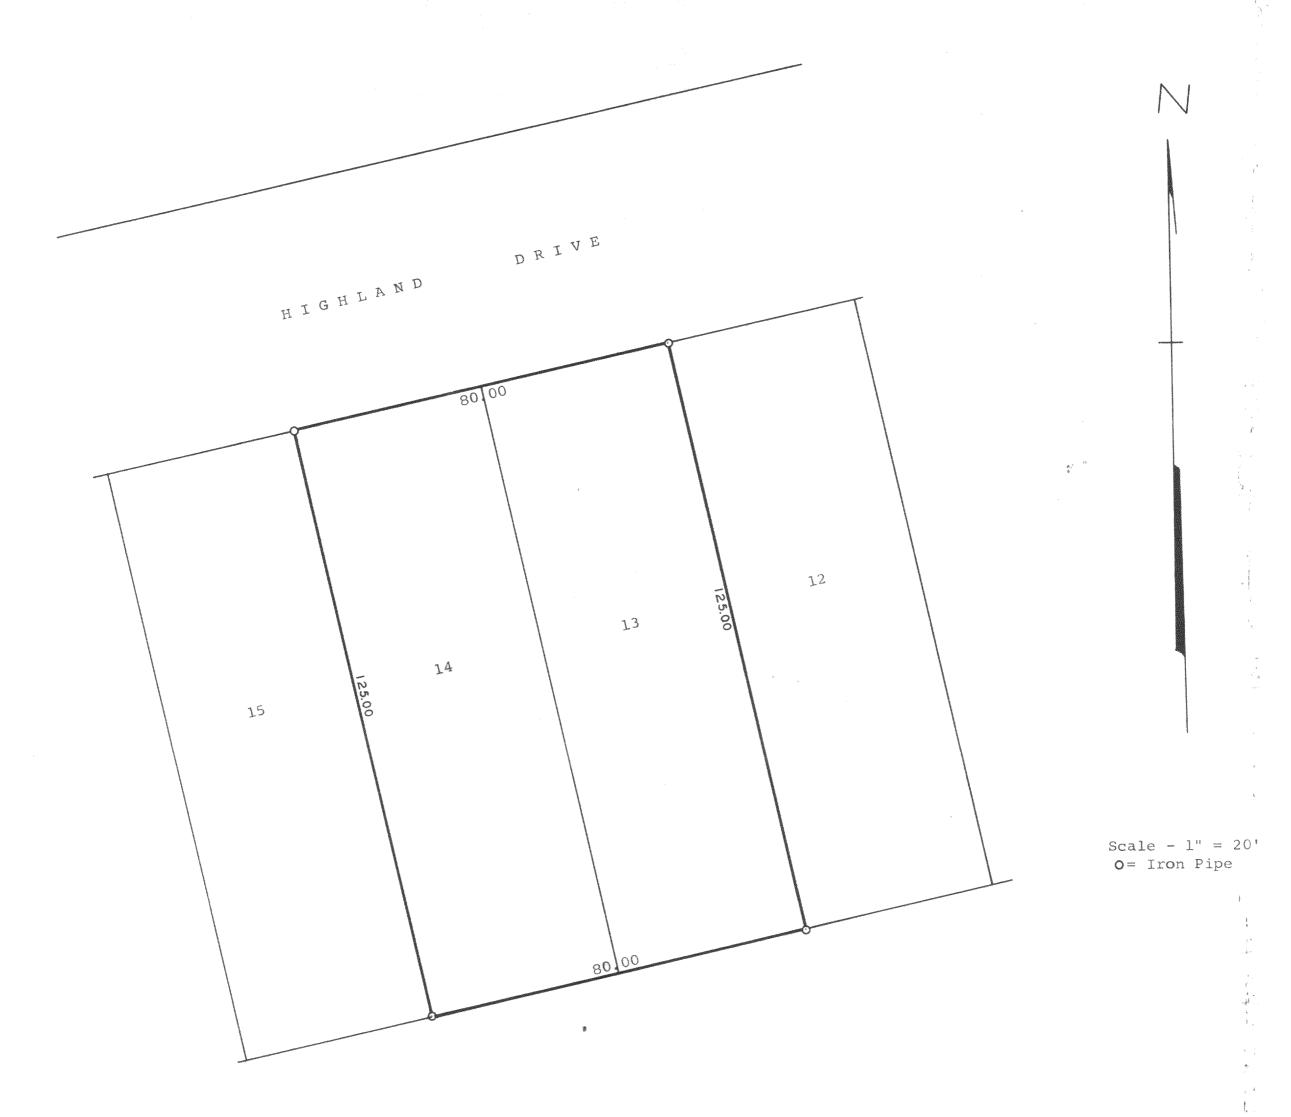

Plat of survey of Lots 13 & 14, Block 19, Delavan Lake View Crest, located in Section 31, T 2 N, R 16 E, Walworth County, Wisconsin.

July 7, 1967

George T. Dunham, Surveyor

216-249