



ABELL  
SURVEYING & MAPPING

1140 SEQUOIA STREET • DELAVAN, WISCONSIN 53115  
414-728-6737

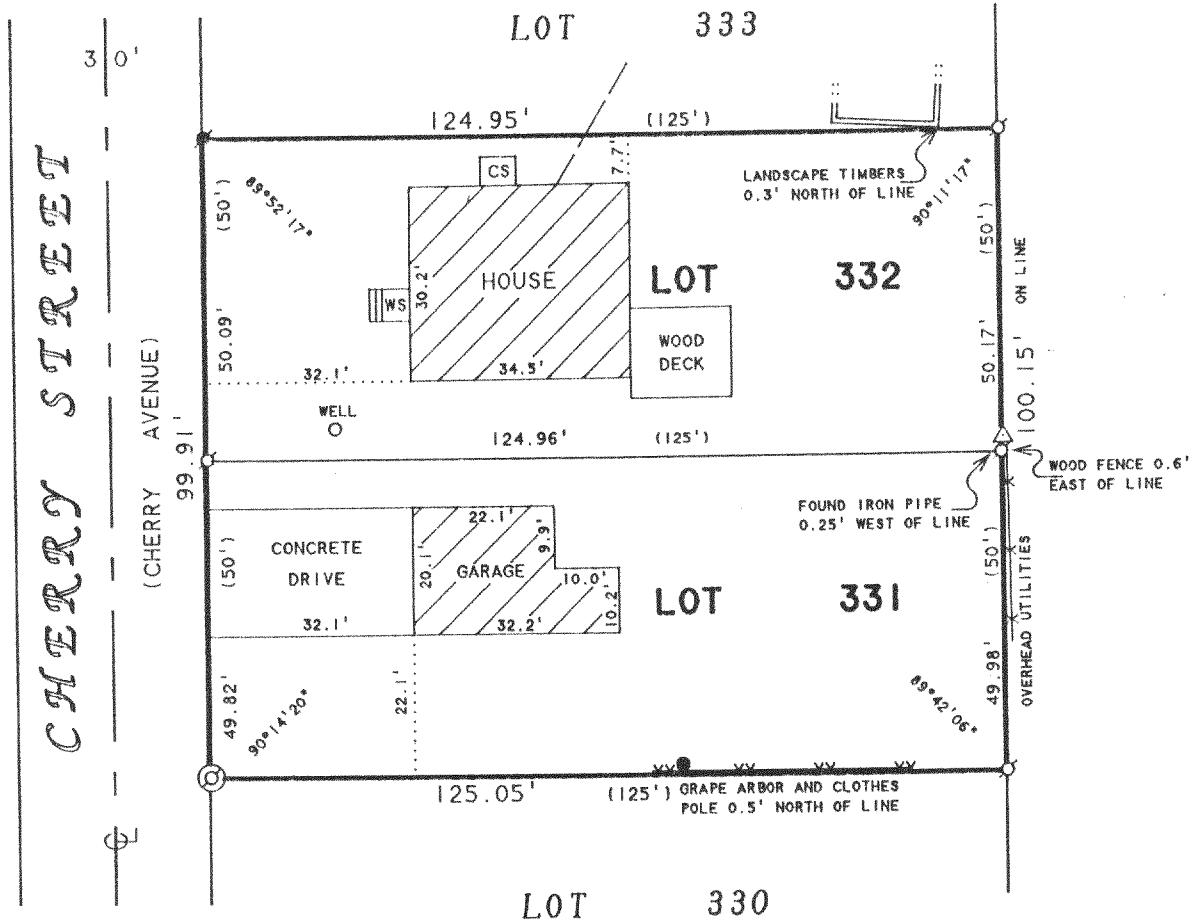

ORDERED BY: CENTURY 21-SKANDIA REALTY  
822 E. GENEVA STREET  
DELAVAN, WI 53115

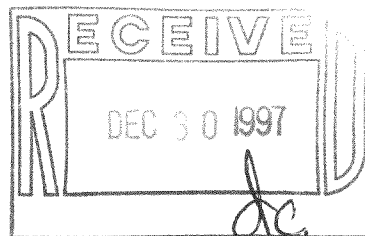

**PLAT OF SURVEY OF**

LOTS 331 AND 332, LAKE DELAVAN HIGHLANDS, LOCATED  
IN T2N, R16E, WALWORTH COUNTY, WISCONSIN.



SCALE 1"=30'

**LEGEND**

- ⊙ - IRON PIPE FOUND
- ⊙ - IRON PIPE IN CONCRETE FOUND
- - IRON ROD FOUND
- △ - UTILITY POLE
- — — — — OVERHEAD UTILITY LINE
- X — X — WOOD FENCE
- XX — XX — GRAPE ARBOR
- - CLOTHES POLE
- CS - CONCRETE STOOP
- WS - WOOD STOOP

I HEREBY CERTIFY THAT I HAVE SURVEYED THE ABOVE DESCRIBED PROPERTY AND THAT THE ABOVE MAP IS A TRUE REPRESENTATION THEREOF AND SHOWS THE SIZE AND LOCATION OF THE PROPERTY, ITS EXTERIOR BOUNDARIES, THE LOCATION OF ALL VISIBLE STRUCTURES AND DIMENSIONS OF ALL PRINCIPAL BUILDINGS THEREON, BOUNDARY FENCES, APPARENT EASEMENTS, ROADWAYS AND VISIBLE ENCROACHMENTS, IF ANY, TO THE BEST OF MY KNOWLEDGE AND BELIEF.

THIS SURVEY IS MADE FOR THE USE OF THE PRESENT OWNERS OF THE PROPERTY, AND ALSO THOSE WHO PURCHASE, MORTGAGE, OR GUARANTEE THE TITLE THERETO WITHIN ONE (1) YEAR FROM DATE HEREON.

*David F. Abell*  
DAVID F. ABELL  
WISCONSIN REGISTERED LAND SURVEYOR, S-1596

October 13, 1997

DATE: \_\_\_\_\_ JOB NUMBER - 97188  
NOTE: THIS IS NOT A CERTIFIED COPY UNLESS SEALED.

FLAD-248

216-2493