


ABELL
SURVEYING & MAPPING


1140 SEQUOIA STREET • DELAVAN, WISCONSIN 53115
414-728-6737

ORDERED BY: RICH FREEMAN
322 SOUTH STREET
ELMHURST, IL 60124

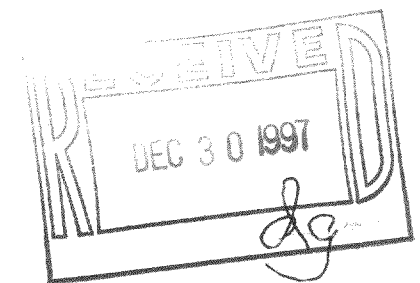

PLAT OF SURVEY OF

LOT 8, BLOCK 1, SUNNY DELL SUBDIVISION,
LOCATED IN T2N, R16E, WALWORTH COUNTY,
WISCONSIN.

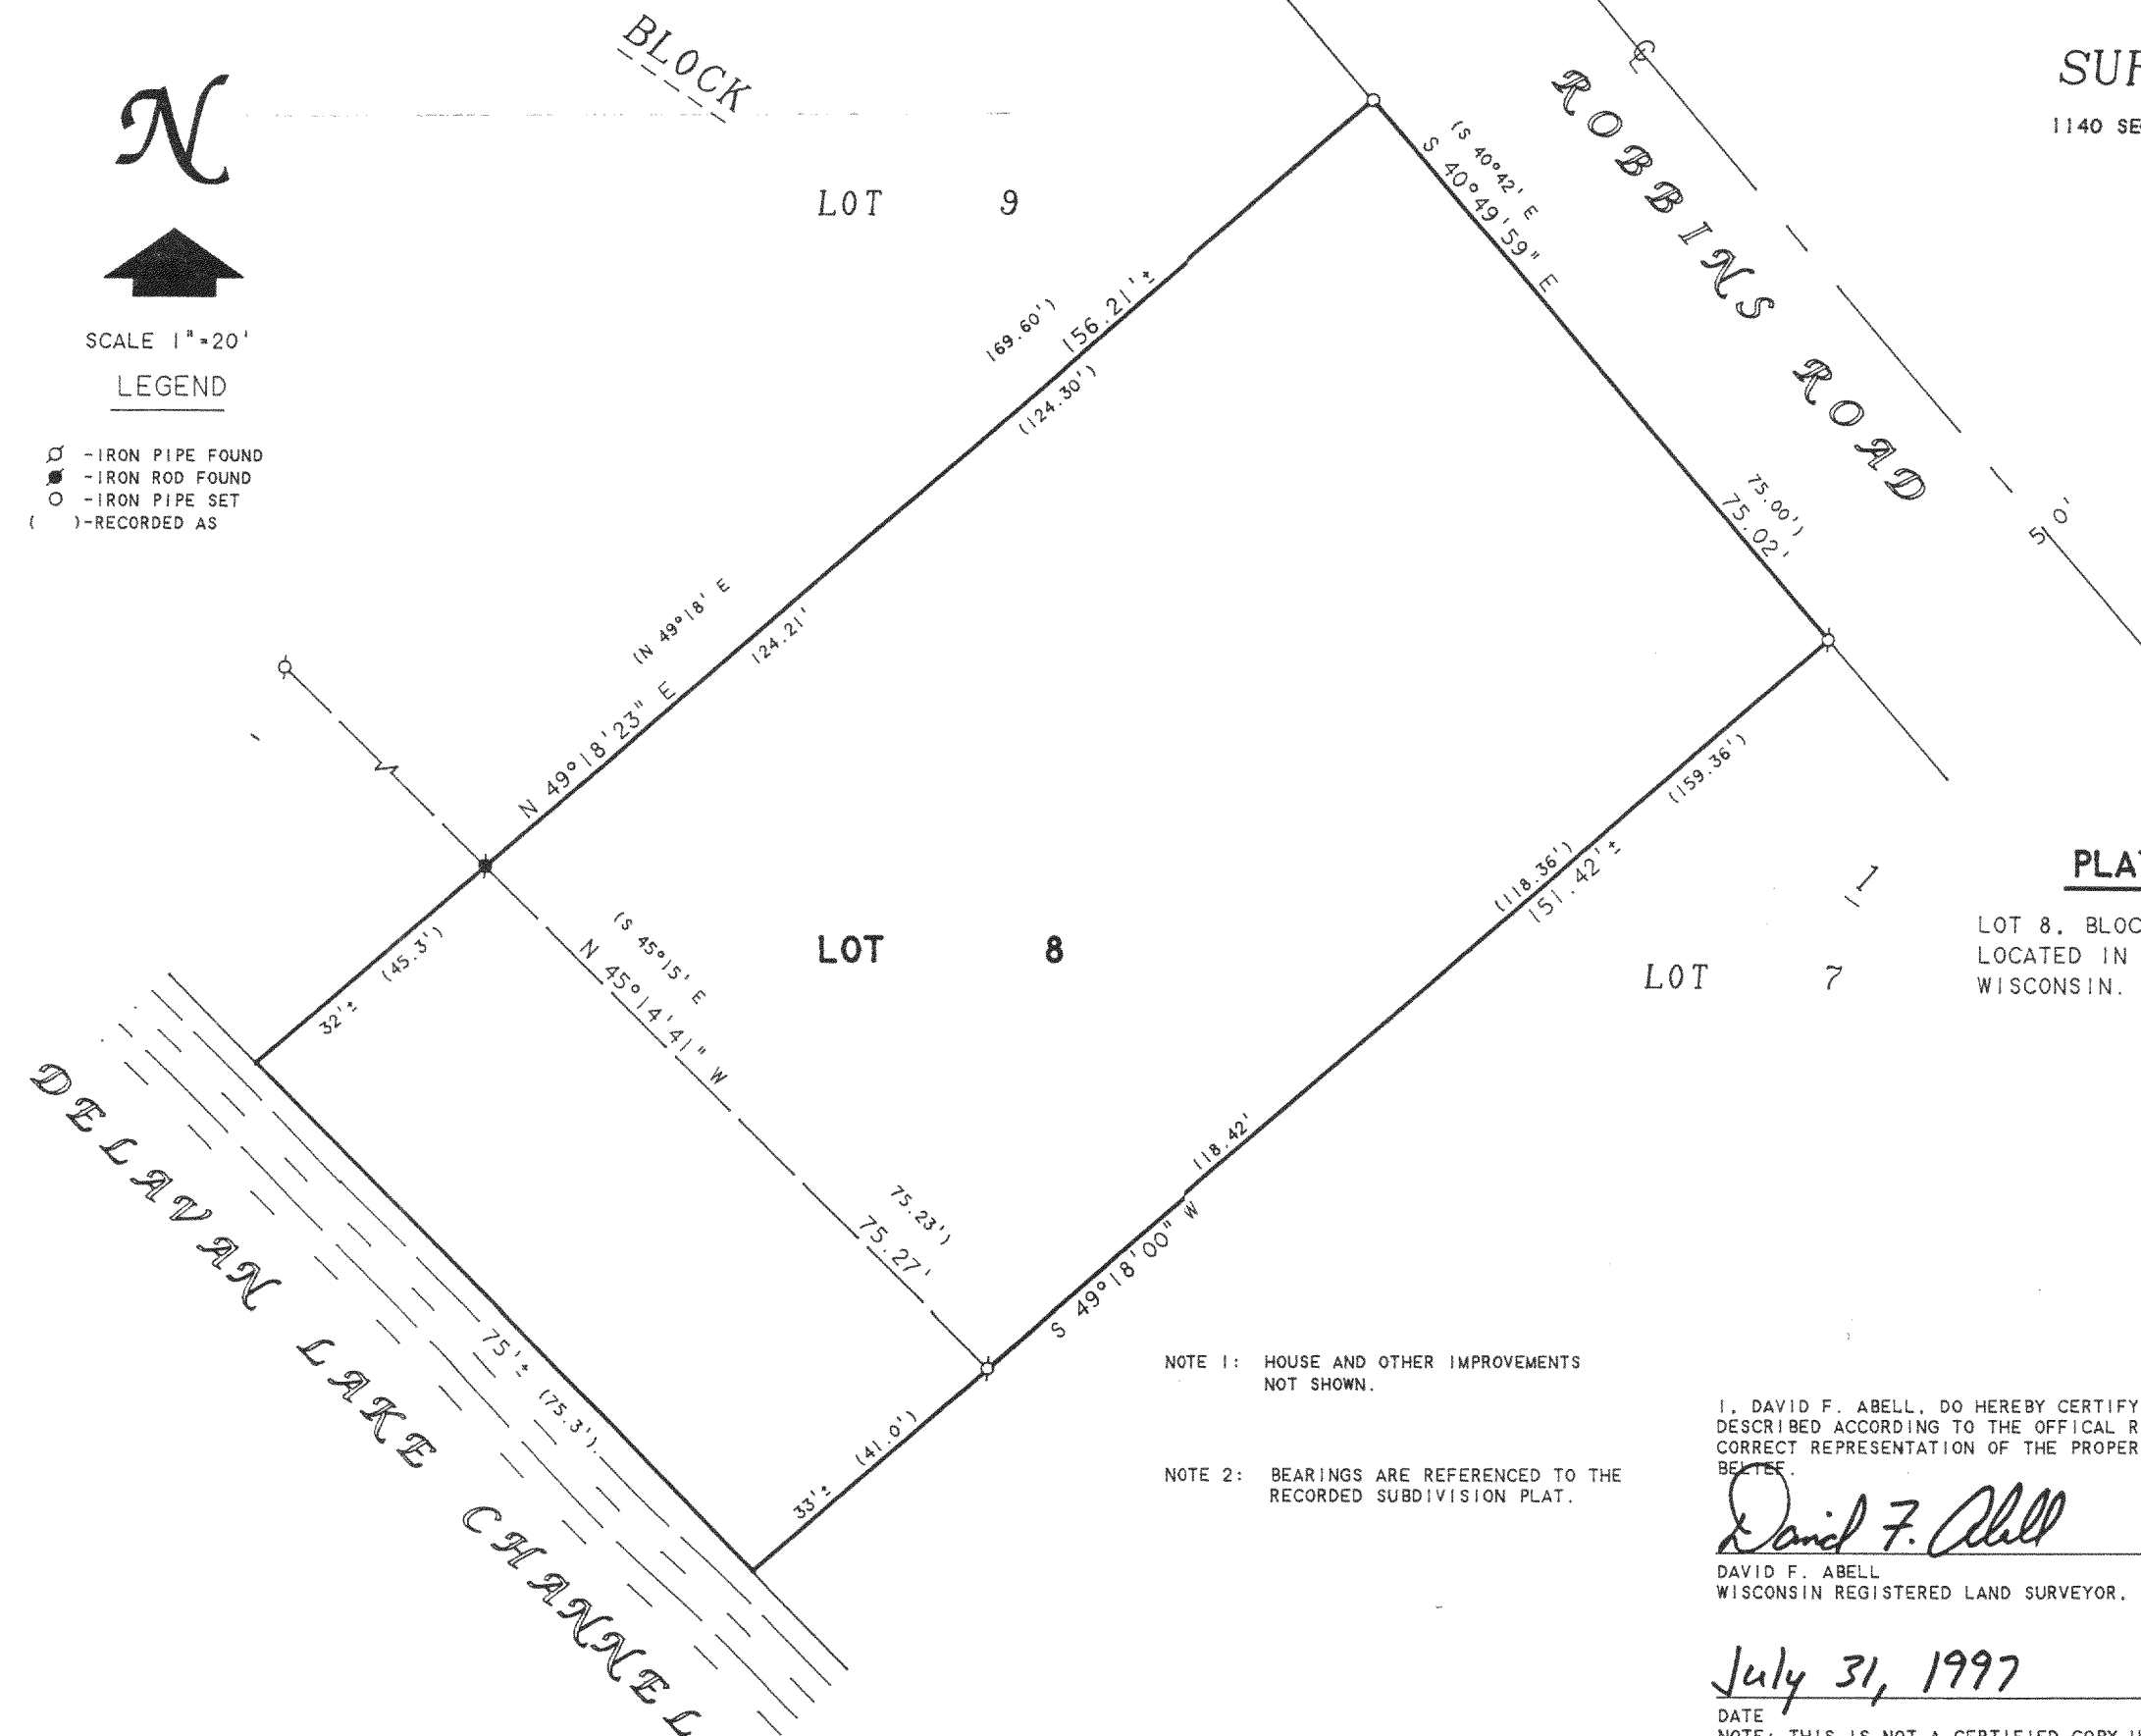

I, DAVID F. ABELL, DO HEREBY CERTIFY THAT I HAVE SURVEYED THE PROPERTY HEREON DESCRIBED ACCORDING TO THE OFFICIAL RECORDS AND THAT THE PLAT HEREON IS A CORRECT REPRESENTATION OF THE PROPERTY LINES TO THE BEST OF MY KNOWLEDGE AND BELIEF.

David F. Abell

DAVID F. ABELL
WISCONSIN REGISTERED LAND SURVEYOR, S-1596

July 31, 1997

DATE: July 31, 1997 JOB NUMBER - 97145
NOTE: THIS IS NOT A CERTIFIED COPY UNLESS SEALED.

Del. FSU-8 216-2511