




1140 SEQUOIA STREET • DELAVAN, WISCONSIN 53115
414-728-6737

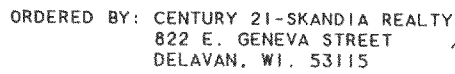

LOT 1, THE ROCKFORD COLONY, LOCATED IN T2N, R16E,
WALWORTH COUNTY, WISCONSIN.

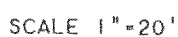

○ - IRON PIPE FOUND
 ● - IRON ROD FOUND
 ● - CONCRETE MONUMENT FOUND
 ○ - IRON PIPE SET
 X — X — WOOD FENCE
 XX — XX — WIRE FENCE
 BE — BASEMENT ENTRY
 CS — CONCRETE STOOP
 — — — — — OVERHEAD UTILITY LINES
 () — RECORDED AS

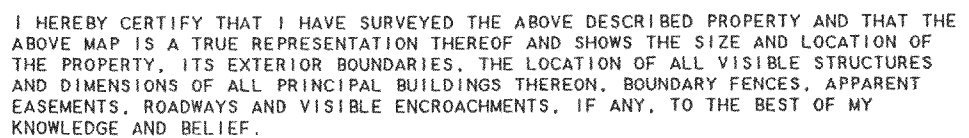

THIS SURVEY IS MADE FOR THE USE OF THE PRESENT OWNERS OF THE PROPERTY, AND ALSO THOSE WHO PURCHASE, MORTGAGE, OR GUARANTEE THE TITLE THERETO WITHIN ONE (1) YEAR FROM DATE HEREON.

DAVID F. ARELL
WISCONSIN REGISTERED LAND SURVEYOR. S-1596

August 29, 1997

DATE _____ JOB NUMBER - 97164
NOTE: THIS IS NOT A CERTIFIED COPY UNLESS SEALED.

216-2520

PROC-1