

N



SCALE 1"=20'

LEGEND


- ⊗ - IRON PIPE FOUND
- - IRON PIPE SET
- △ - UTILITY POLE
- - UTILITY PED
- () - RECORDED AS
- WS - WOOD STOOP
- - IRON ROD FOUND

ORDERED BY: BOB HERTEL
 10510 ALTGELD
 MELROSE PARK, IL 60164

NOTE: THE BEARING ON THE WEST LINE OF
 CHERRY STREET IS ASSUMED NORTH.

ABELL
 SURVEYING & MAPPING


1140 SEQUOIA STREET • DELAVAN, WISCONSIN 53115
 414-728-6737

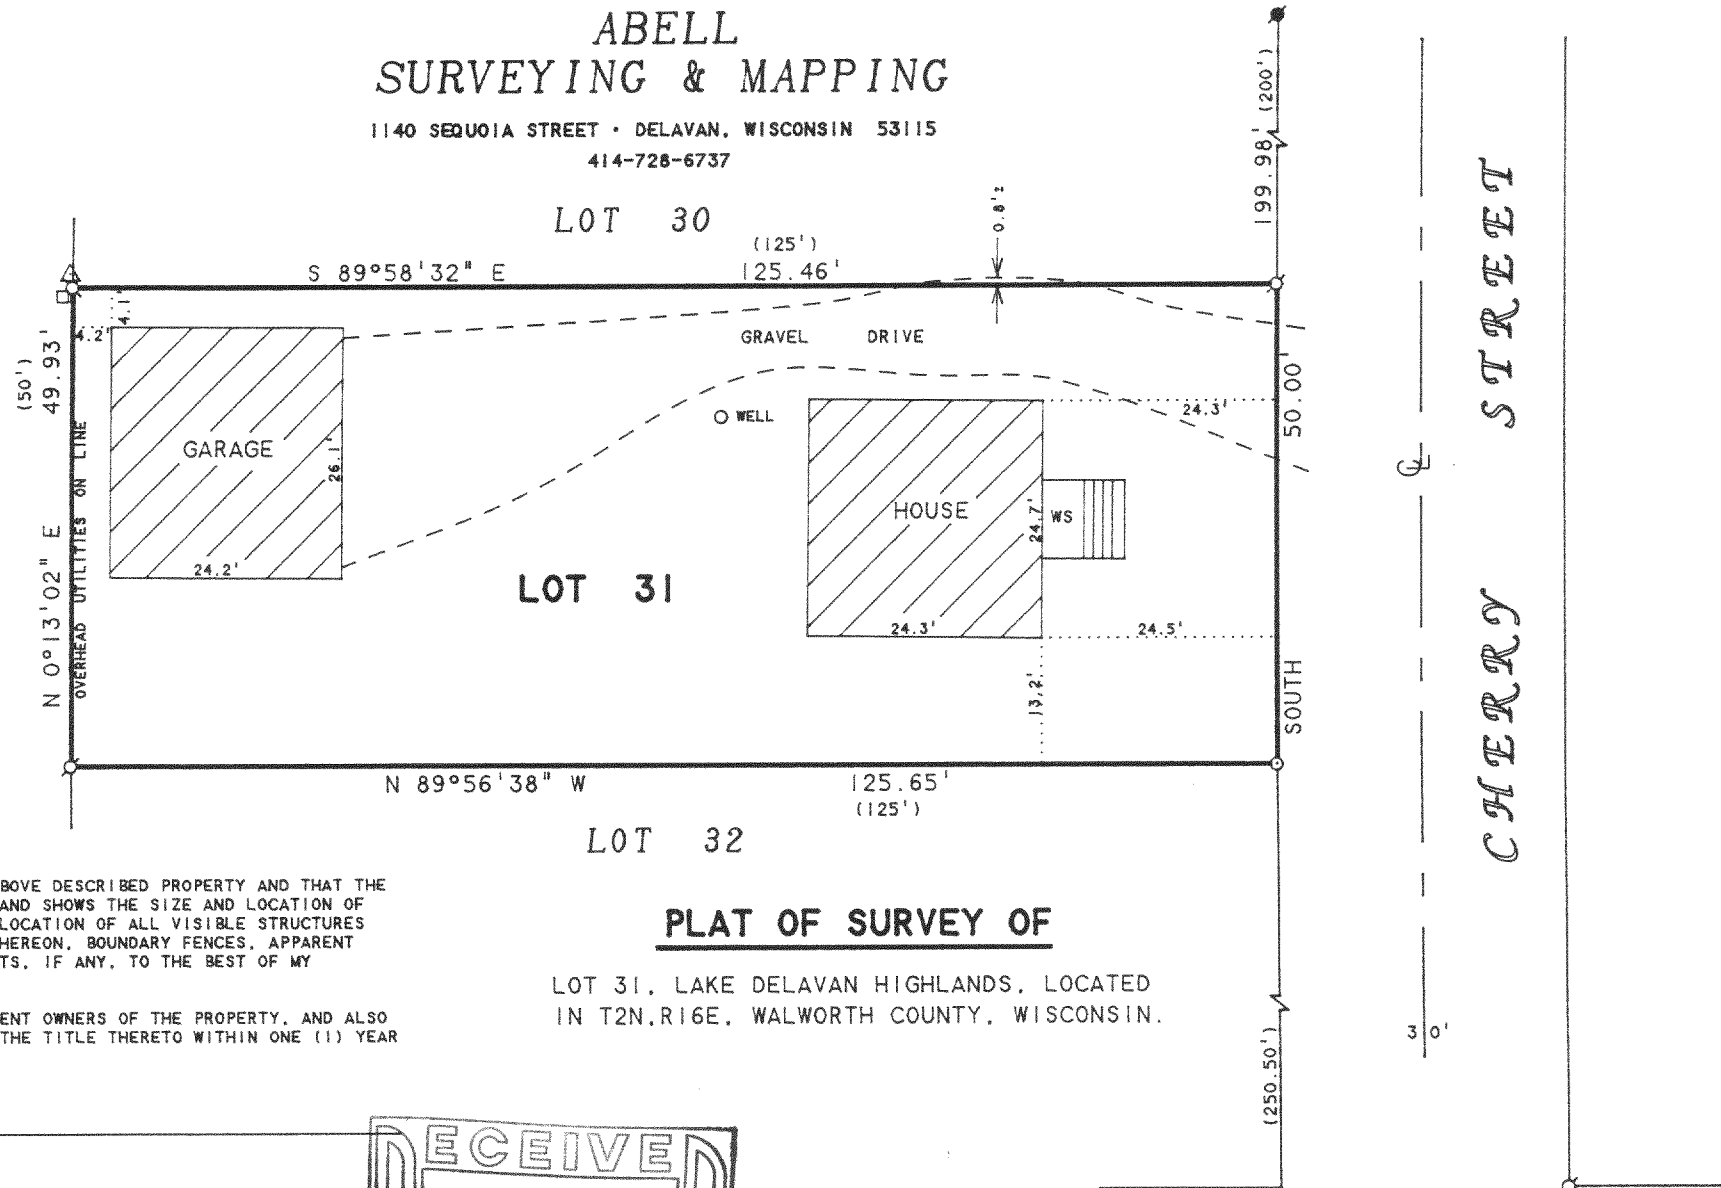

I HEREBY CERTIFY THAT I HAVE SURVEYED THE ABOVE DESCRIBED PROPERTY AND THAT THE ABOVE MAP IS A TRUE REPRESENTATION THEREOF AND SHOWS THE SIZE AND LOCATION OF THE PROPERTY, ITS EXTERIOR BOUNDARIES, THE LOCATION OF ALL VISIBLE STRUCTURES AND DIMENSIONS OF ALL PRINCIPAL BUILDINGS THEREON, BOUNDARY FENCES, APPARENT EASEMENTS, ROADWAYS AND VISIBLE ENCROACHMENTS, IF ANY, TO THE BEST OF MY KNOWLEDGE AND BELIEF.

THIS SURVEY IS MADE FOR THE USE OF THE PRESENT OWNERS OF THE PROPERTY, AND ALSO THOSE WHO PURCHASE, MORTGAGE, OR GUARANTEE THE TITLE THERETO WITHIN ONE (1) YEAR FROM DATE HEREON.

David F. Abell
 DAVID F. ABELL
 WISCONSIN REGISTERED LAND SURVEYOR, S-1596

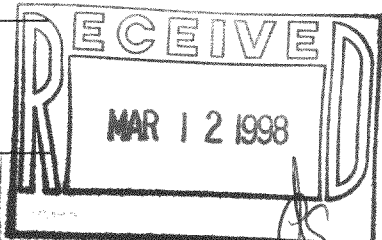

January 8, 1998
 DATE JOB NUMBER - 97237
 NOTE: THIS IS NOT A CERTIFIED COPY UNLESS SEALED.

FLAD-217
 216-2528