

1140 SEQUOIA STREET • DELAVAN, WISCONSIN 53115
414-728-6737

INLET ROAD

LOT 34

LOT 35

LOT 36

HOUSE

GARAGE

BLACKTOP PARKING AREA

DELAVAN LAKE INLET

PIER

PLAT OF

LOT 35, THE ANNEX
IN T2N, R16E, W4E

D BY: TOWN & LAKE REAL ESTATE
6467 HIGHWAY 11
DELAVAN, WI 53115



LOT 35, THE ANNEX TO INLET OAKS, LOCATED
IN T2N, R16E, WALWORTH COUNTY, WISCONSIN.

ORDERED BY: TOWN & LAKE REAL ESTATE
6467 HIGHWAY 11
DELAVER, WI 53115

 \mathcal{N} 

SCALE 1" = 30'

LEGEND

-  -IRON PIPE FOUND
 -IRON ROD FOUND
WS -WOOD STOOP
XX-XX-XX -WIRE FENCE
--*-WOOD FENCE
-----OVERHEAD UTILITY LINES
()-RECORDED AS

I HEREBY CERTIFY THAT I HAVE SURVEYED THE ABOVE DESCRIBED PROPERTY AND THAT THE ABOVE MAP IS A TRUE REPRESENTATION THEREOF AND SHOWS THE SIZE AND LOCATION OF THE PROPERTY, ITS EXTERIOR BOUNDARIES, THE LOCATION OF ALL VISIBLE STRUCTURES AND DIMENSIONS OF ALL PRINCIPAL BUILDINGS THEREON, BOUNDARY FENCES, APPARENT EASEMENTS, ROADWAYS AND VISIBLE ENCROACHMENTS, IF ANY, TO THE BEST OF MY KNOWLEDGE AND BELIEF.

THIS SURVEY IS MADE FOR THE USE OF THE PRESENT OWNERS OF THE PROPERTY, AND ALSO THOSE WHO PURCHASE, MORTGAGE, OR GUARANTEE THE TITLE THERETO WITHIN ONE (1) YEAR FROM DATE HEREON.


FROM DATE HEREON:

Land F. Bell

DAVID F. ABELL
WISCONSIN REGISTERED LAND SURVEYOR, S-1596

April 16, 1998

DATE _____ JOB NUMBER - 98057
NOTE: THIS IS NOT A CERTIFIED COPY UNLESS SEALED.

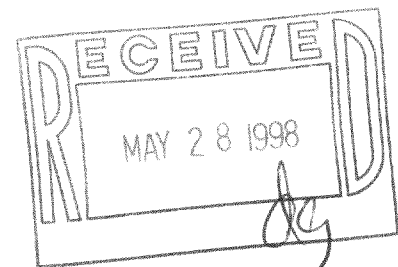

216-2572
FIA-26