


ABELL
SURVEYING & MAPPING


1140 SEQUOIA STREET • DELAVAN, WISCONSIN 53115
414-728-6737

LOT 1

CERTIFIED SURVEY MAP No. 2029

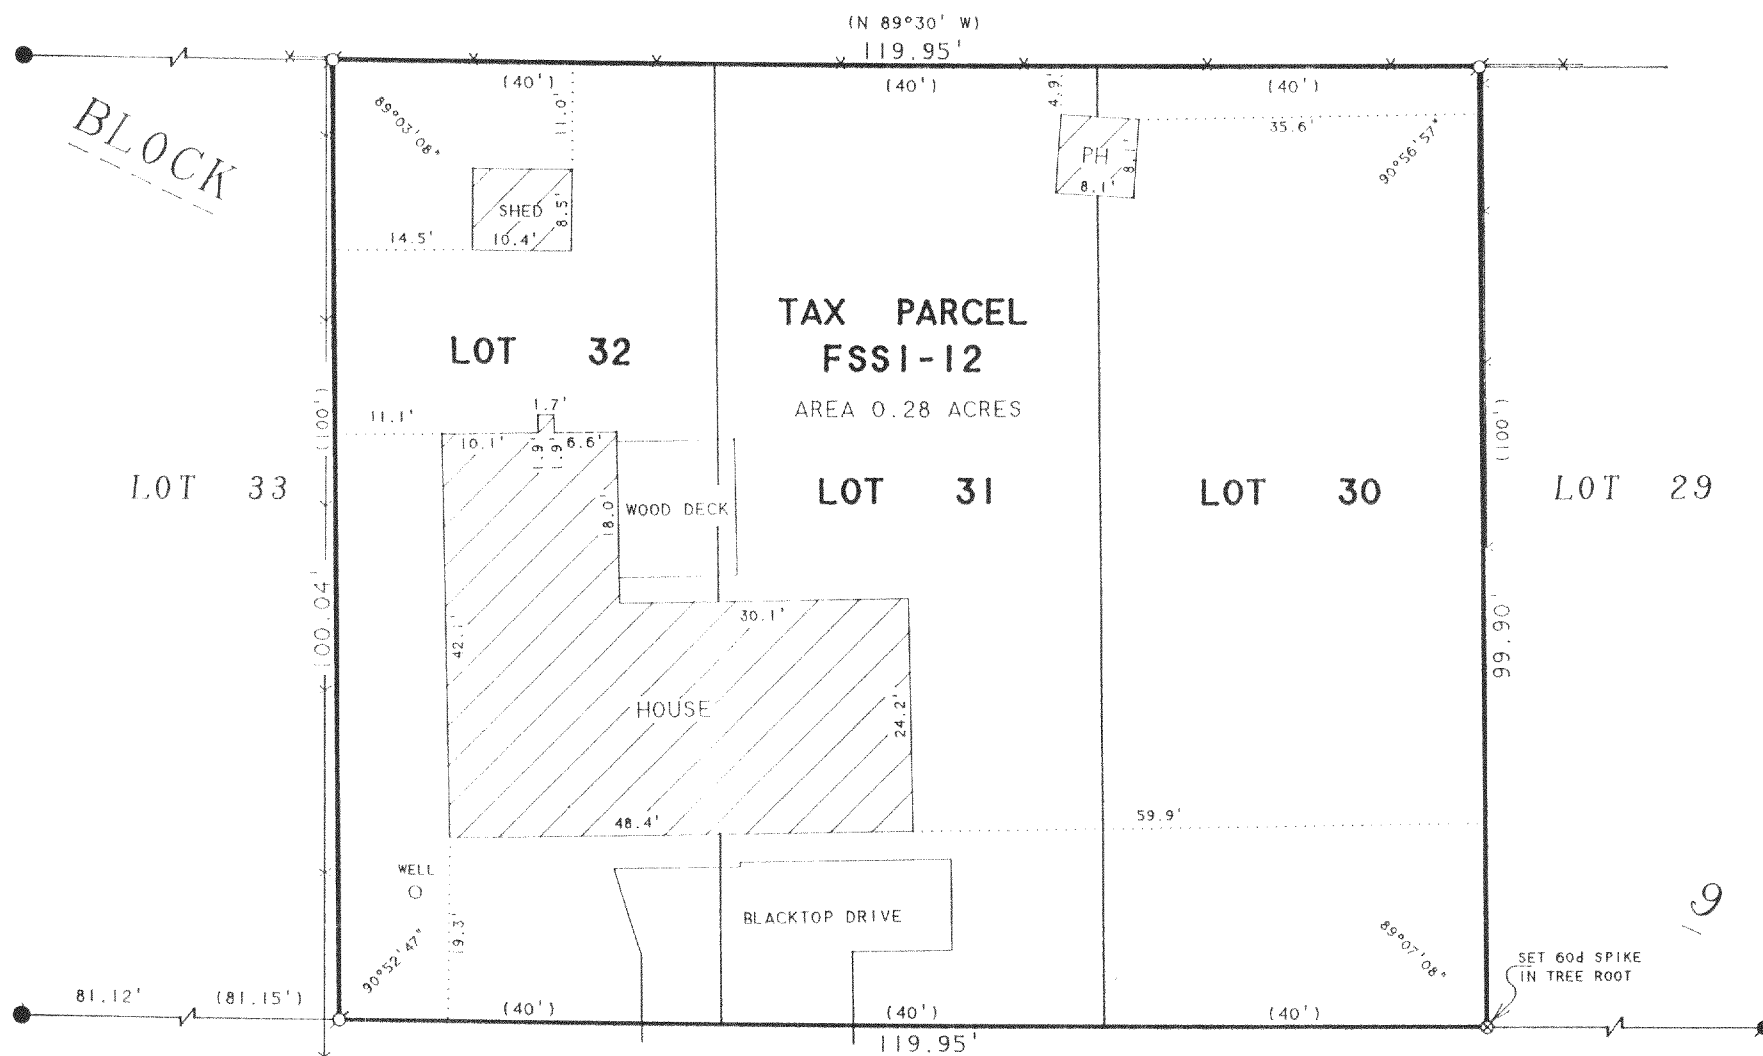

JUNIOR TERRACE

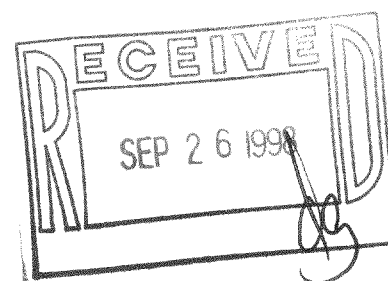

ORDERED BY: PAUL BROCKWELL
2206 JUNIOR TERRACE
DELAVAN, WI 53115

PLAT OF SURVEY OF

LOTS 30-32, BLOCK 9, SOUTH SHORE MANOR
FIRST ADDITION, LOCATED IN T2N, R16E,
WALWORTH COUNTY, WISCONSIN.

N



SCALE 1"=20'

LEGEND

- - IRON PIPE FOUND
- - CONCRETE MONUMENT FOUND
- - IRON ROD FOUND
- ⊗ - 60d SPIKE SET
- PH - PLAY HOUSE
- × - WIRE FENCE
- () - RECORDED AS

I, DAVID F. ABELL, DO HEREBY CERTIFY THAT I HAVE SURVEYED THE PROPERTY HEREON DESCRIBED ACCORDING TO THE OFFICIAL RECORDS AND THAT THE PLAT HEREON IS A CORRECT REPRESENTATION OF THE PROPERTY LINES TO THE BEST OF MY KNOWLEDGE AND BELIEF.

David F. Abell

DAVID F. ABELL
WISCONSIN REGISTERED LAND SURVEYOR, S-1596

July 23, 1998

DATE: July 23, 1998 JOB NUMBER - 98130
NOTE: THIS IS NOT A CERTIFIED COPY UNLESS SEALED.

216-2637
FSS1-12