

ABELL
SURVEYING & MAPPING
DELAVAN, WISCONSIN 53115
414-728-6737

RECERTIFIED: AUGUST 7, 1998
ORDERED BY: KAREN HETRICK
714 FARYL AVE. #11
DELAVAN, WI 53115

PLAT OF SURVEY OF

LOT 13, LAKEWOOD ESTATES, LOCATED
IN T2N, R16E, WALWORTH COUNTY,
WISCONSIN.

ORDERED BY: PROFESSIONAL REALTY
706 E. GENEVA ST.
DELAVAN, WI. 53115

N



SCALE 1"=30'


LEGEND

- ⊗ -IRON PIPE FOUND
- -CONCRETE MONUMENT FOUND
- ⊗ -MANHOLE COVER
- () -RECORDED AS

NOTE: BEARINGS ARE REFERENCED TO THE
RECORDED SUBDIVISION PLAT.

LAKE

TRAIL

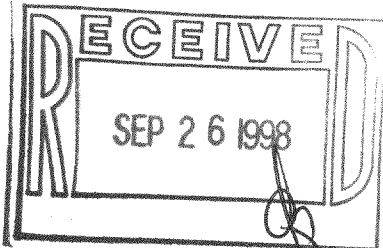

I HEREBY CERTIFY THAT I HAVE SURVEYED THE ABOVE DESCRIBED PROPERTY AND THAT THE
ABOVE MAP IS A TRUE REPRESENTATION THEREOF AND SHOWS THE SIZE AND LOCATION OF
THE PROPERTY, ITS EXTERIOR BOUNDARIES, THE LOCATION OF ALL VISIBLE STRUCTURES
AND DIMENSIONS OF ALL PRINCIPAL BUILDINGS THEREON, BOUNDARY FENCES, APPARENT
EASEMENTS, ROADWAYS AND VISIBLE ENCROACHMENTS, IF ANY, TO THE BEST OF MY
KNOWLEDGE AND BELIEF.

THIS SURVEY IS MADE FOR THE USE OF THE PRESENT OWNERS OF THE PROPERTY, AND ALSO
THOSE WHO PURCHASE, MORTGAGE, OR GUARANTEE THE TITLE THERETO WITHIN ONE (1) YEAR
FROM DATE HEREON.

David F. Abell

DAVID F. ABELL
WISCONSIN REGISTERED LAND SURVEYOR, S-1596

October 25, 1993

DATE: JOB NUMBER - 93242
NOTE: THIS IS NOT A CERTIFIED COPY UNLESS SEALED.

216-2638
FLE-13