
ABELL SURVEYING & MAPPING

1140 SEQUOIA STREET . DELAVAN, WISCONSIN 53115 414-728-6737

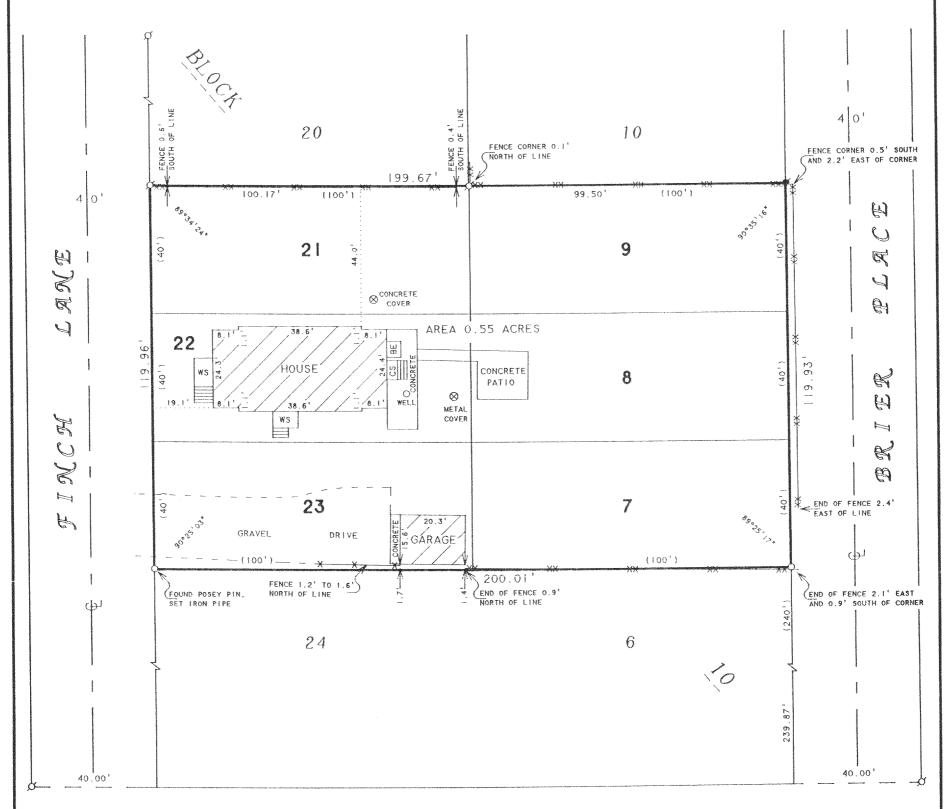

ADALIA

AVENUE

I HEREBY CERTIFY THAT I HAVE SURVEYED THE ABOVE DESCRIBED PROPERTY AND THAT TH ABOVE MAP IS A TRUE REPRESENTATION THEREOF AND SHOWS THE SIZE AND LOCATION OF THE PROPERTY, ITS EXTERIOR BOUNDARIES, THE LOCATION OF ALL VISIBLE STRUCTURES AND DIMENSIONS OF ALL PRINCIPAL BUILDINGS THEREON, BOUNDARY FENCES, APPARENT EASEMENTS, ROADWAYS AND VISIBLE ENCROACHMENTS, IF ANY, TO THE BEST OF MY KNOWLEDGE AND BELIEF.

THIS SURVEY IS MADE FOR THE USE OF THE PRESENT OWNERS OF THE PROPERTY. AND ALSO THOSE WHO PURCHASE, MORTGAGE, OR GUARANTEE THE TITLE THERETO WITHIN ONE (I) YEAR

PLAT OF SURVEY OF

LOTS 7-9 AND 21-23, BLOCK 10, SOUTH SHORE MANOR FIRST ADDITION, LOCATED IN T2N, RIGE, WALWORTH COUNTY, WISCONSIN.



1155 E. GENEVA STREET

DELAVAN, WI 53115

ORDERED BY: KEEFE REAL ESTATE



SCALE | " = 30 "

LEGEND

- IRON ROD FOUND O - IRON PIPE SET WS -WOOD STOOP CS -CONCRETE STOOP BE - BASEMENT ENTRY -XX -WIRE FENCE

()-RECORDED AS

DAVID F. ABELL

WISCONSIN REGISTERED LAND SURVEYOR, 5-1596

August 19, 1998

JOB NUMBER - 98148



216-2639