

FARRIS, HANSEN & ASSOCIATES, INC.
7 RIDGWAY COURT - P.O. BOX 437, ELKHORN, WISCONSIN, 53121
ENGINEERING, ARCHITECTURE, SURVEYING
PHONE: (414) 723-2098 FAX: (414) 723-5886


PLAT OF SURVEY

LOT 1 OF GENEVA WEST ESTATES
LOCATED IN PART OF THE SOUTHEAST 1/4 OF
OF SECTION 25, TOWN 2 NORTH, RANGE 16 EAST,
TOWN OF DELAVAN, WALWORTH COUNTY, WISCONSIN

- WORK ORDERED BY -
JOHN BAKKEN/GENEVA HOMES, INC.
P.O. BOX 877
WILLIAMS BAY, WISCONSIN 53191

BENCHMARK:
60 PENNY NAIL
IN 8" CHERRY TREE
ELEV: 108.03(ASSUMED)

COUNTRYSIDE DRIVE
(66' WIDE)
EDGE OF PAVEMENT

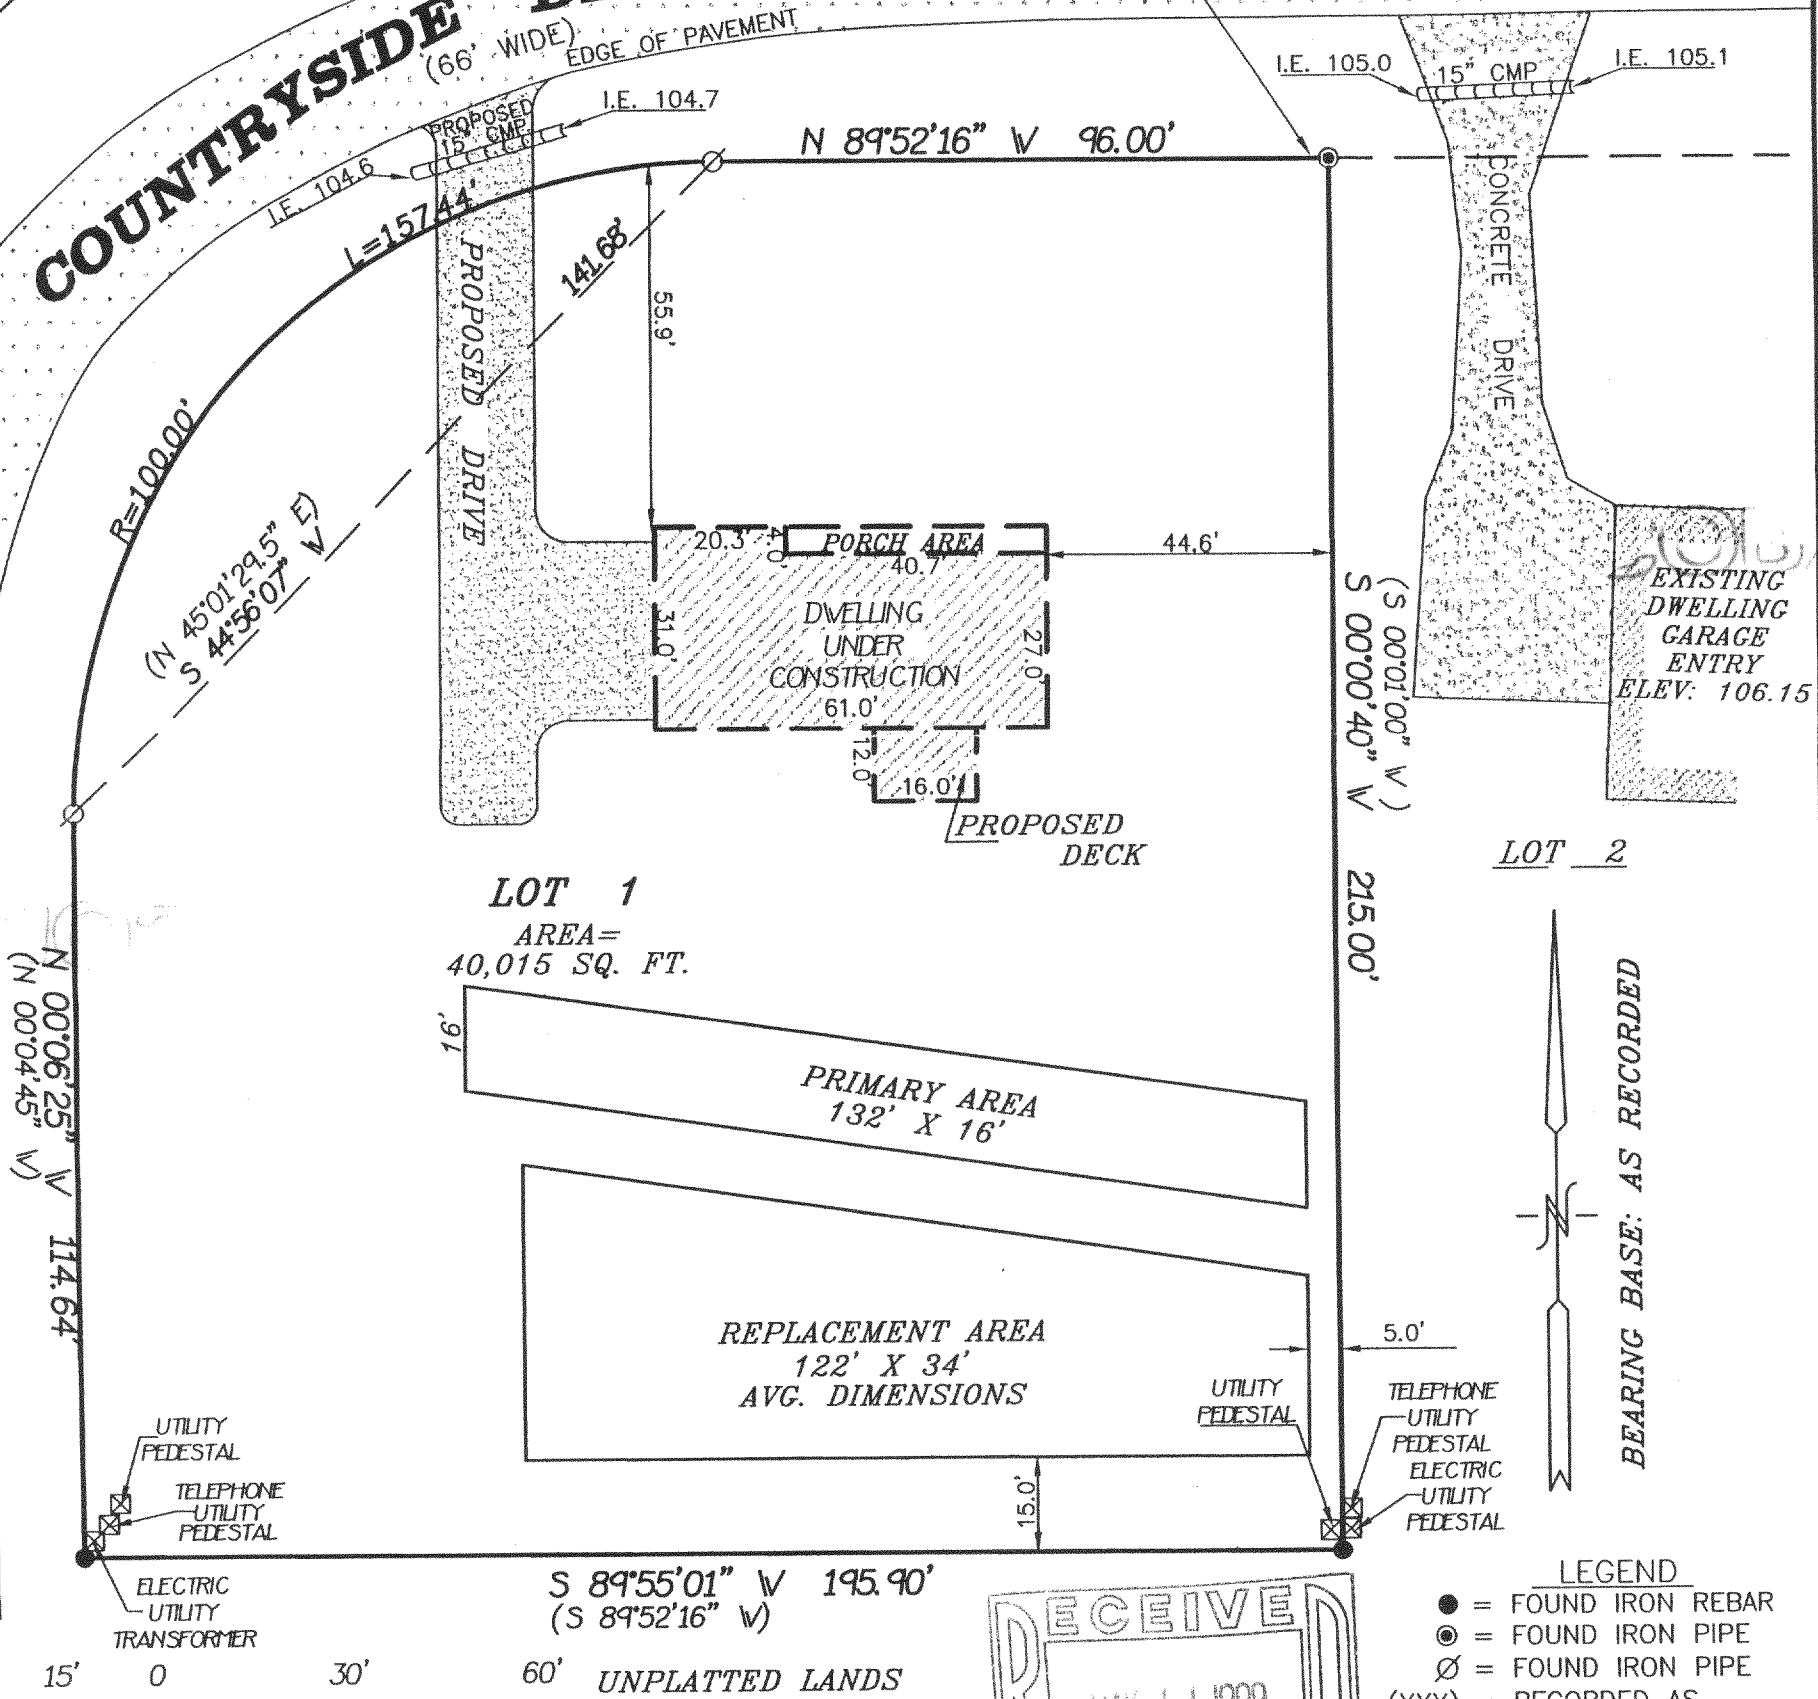

NOTE: COPIES OF THIS MAP TO WHICH THE FOLLOWING CERTIFICATE WILL APPLY SHOW SURVEYOR'S ORIGINAL SEAL AND SIGNATURE IN BLACK INK. COPIES BY ANY OTHER MEANS MAY HAVE ALTERATIONS WHICH DO NOT REPRESENT THE SURVEYOR'S WORK PRODUCT.

I HEREBY CERTIFY THAT THE ABOVE DESCRIBED PROPERTY HAS BEEN SURVEYED UNDER MY DIRECTION AND THAT THE ABOVE MAP IS A TRUE REPRESENTATION THEREOF AND SHOWS THE SIZE AND LOCATION OF THE PROPERTY AND ITS EXTERIOR BOUNDARIES. THIS SURVEY IS MADE FOR THE USE OF THE PRESENT OWNERS OF THE PROPERTY, AND ALSO THOSE WHO PURCHASE, MORTGAGE, OR GUARANTEE THE TITLE THERETO WITHIN ONE YEAR FROM THE DATE HEREOF.

REVISED DATE: JANUARY 27, 1999

RECERTIFIED: FEBRUARY 18, 1999

RANDAL J. MATHWICK RLS 2411



PROJECT 5174
DATE: 1/27/1999
SHEET 1 OF 1

FGEW-1
216-2710