



# PLAT OF SURVEY

**PATHFINDER SURVEYING**  
 FORMERLY KOLB LAND CONSULTING  
 929 WILLIAMS STREET LAKE GENEVA, WI. 53147  
 (414) 248-3697

ORDERED BY: CENTURY 21 SKANDIA REALTY  
 822 E GENEVA ST.  
 DELEVAN, WI 53115

DATE: 6-17-1999

DESCRIPTION: LOT 19 IN LAKE DELAVAN HIGHLANDS, BEING A  
 SUBDIVISION LOCATED IN THE SOUTH 1/2 OF THE  
 SOUTHEAST 1/4 OF SECTION 31 T2N, R16E,  
 WALWORTH COUNTY, WISCONSIN.

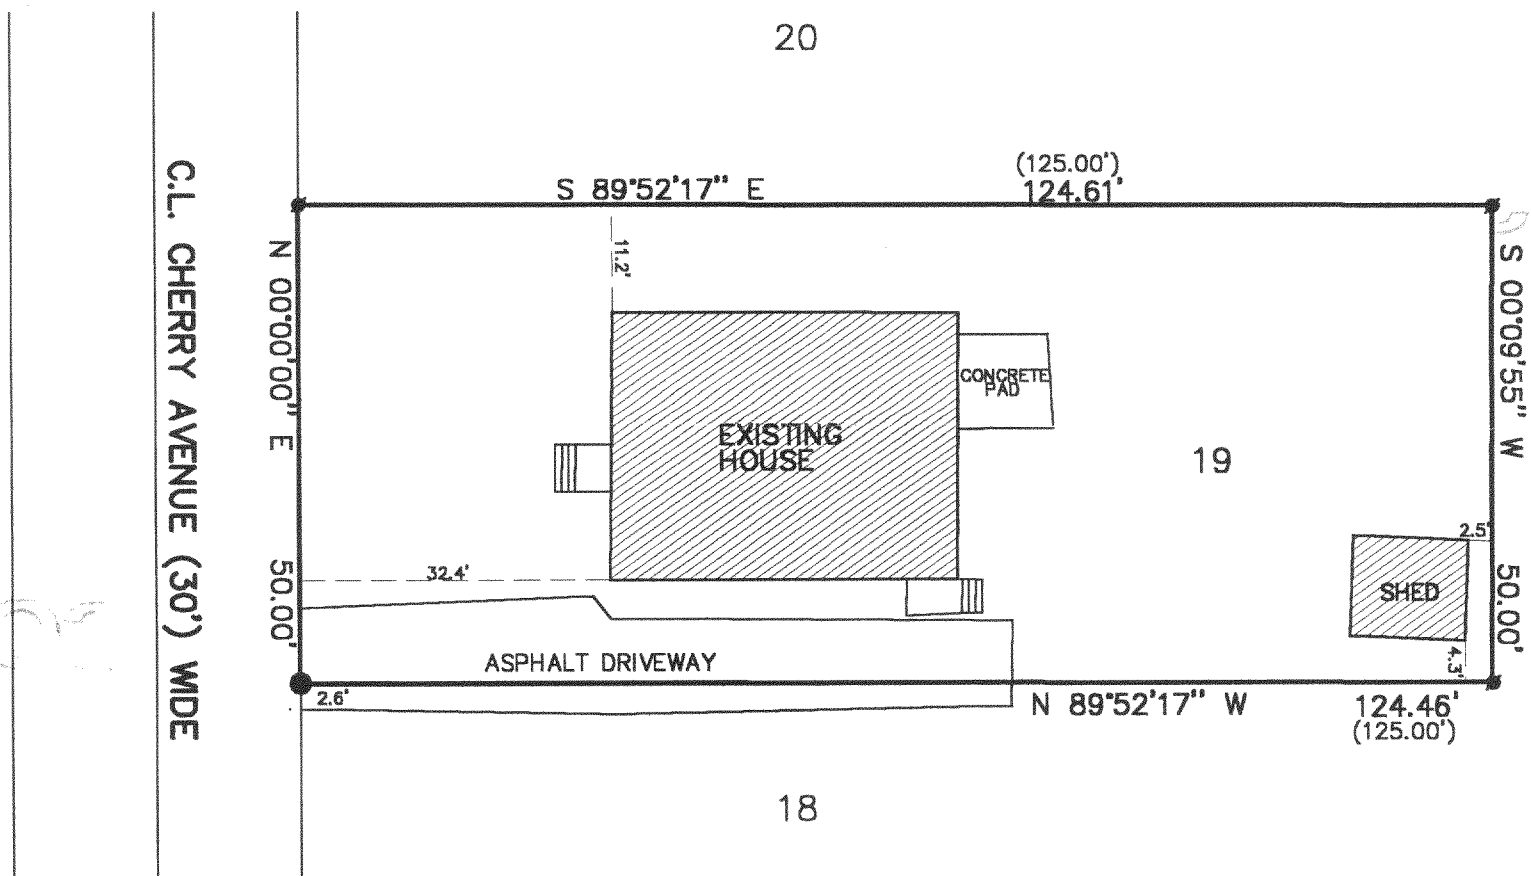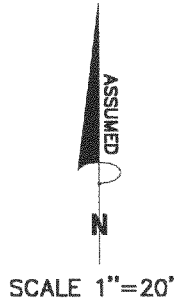


- LEGEND
- FOUND IRON PIPE
  - SET IRON PIPE
  - SET RAILROAD SPIKE
  - (XXX) RECORDED AS

THE ABOVE MAP IS A TRUE REPRESENTATION THEREOF AND SHOWS THE SIZE AND LOCATION OF ALL THE PROPERTY, EXTERIOR BOUNDARIES, THE LOCATION OF ALL VISIBLE BOUNDARY FENCES, APPARENT EASEMENTS, ROADWAYS AND VISIBLE ENCROACHMENTS, IF ANY

THIS SURVEY IS MADE FOR THE USE OF THE PRESENT OWNERS OF THE PROPERTY, AND ALSO THOSE WHO PURCHASE, MORTGAGE OR GUARANTEE TITLE THERETO WITHIN ONE (1) YEAR FROM DATE HERETO.

*John P. Krott*  
 JOHN P. KROTT, R.L.S. 2258

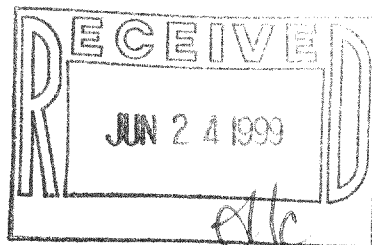

NOTE: THIS IS NOT A CERTIFIED COPY UNLESS SEAL IS IN RED.  
 JOB NUMBER 99134 2-16 FLAD 00017

FLAD-17

216-2748