
GEORGE T. DUNHAM SURVEYING & SUBDIVIDING DELAYAN, WISCONSIN

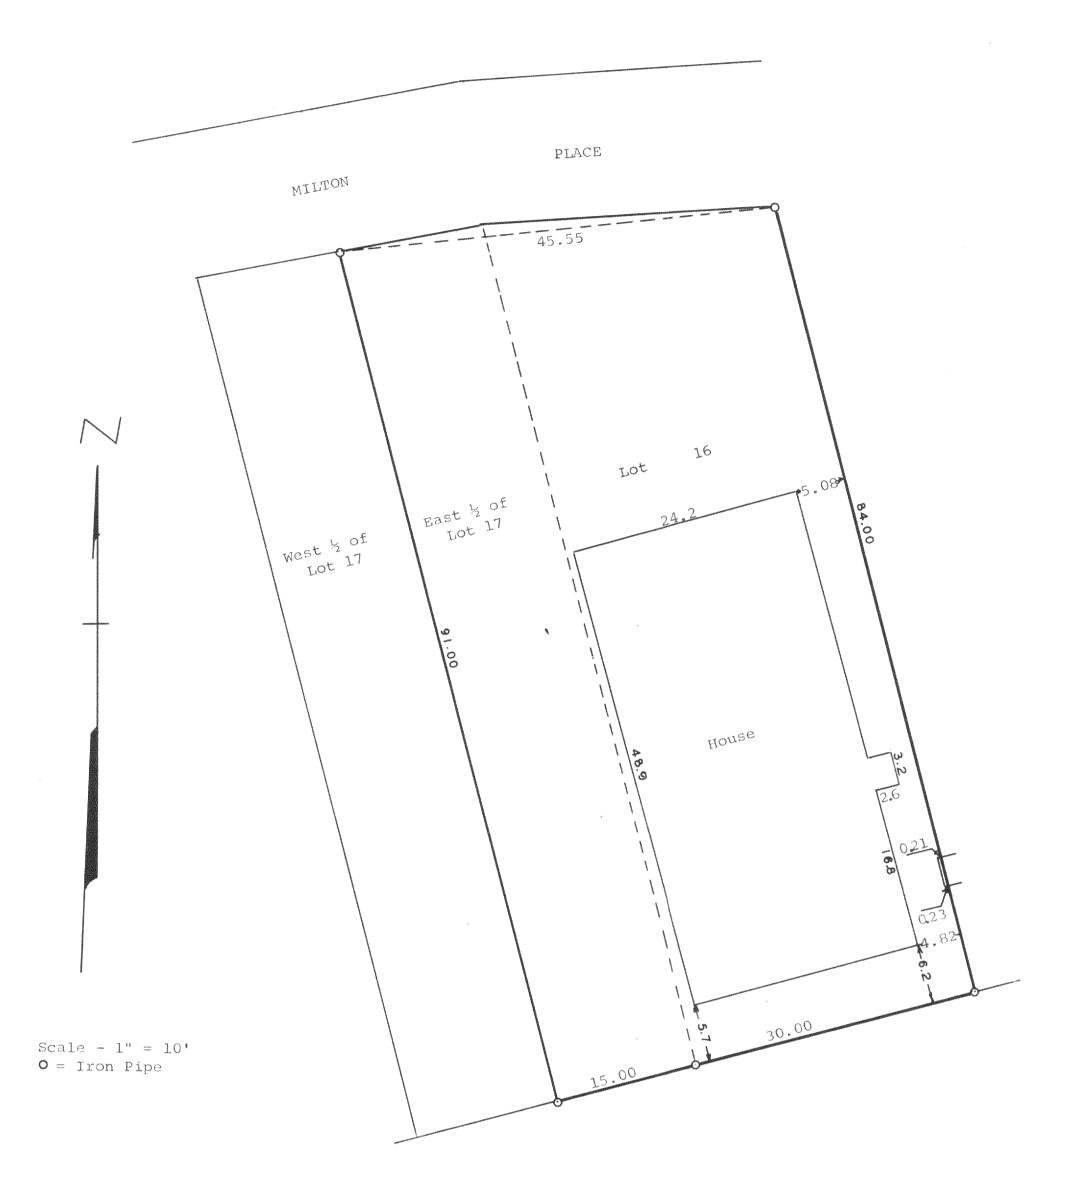

STATE OF WISCONSIN) SS WALWORTH COUNTY)

I, George T. Dunham, Surveyor, certify that I have surveyed the property described as follows,

Lot 16 and the East 1/2 of Lot 17, Block "Q", Delavan

Lake Assembly Grounds, a subdivision located in Section 21, T 2 N, R 16 E, Walworth County, Wisconsin. and that the above plat is an accurate survey and a true

representation thereof and correctly shows the exterior lines and location of buildings on said property and the correct measurements thereof.

May 21, 1969

George T. Dunham, Surveyor

FDLA-181

K & E 10-7155 250-3-68