


**ABELL  
SURVEYING & MAPPING**  
1140 SEQUOIA STREET • DELAVAN, WISCONSIN 53115  
414-728-6737


RIDGE AVENUE

SPRUCE DRIVE

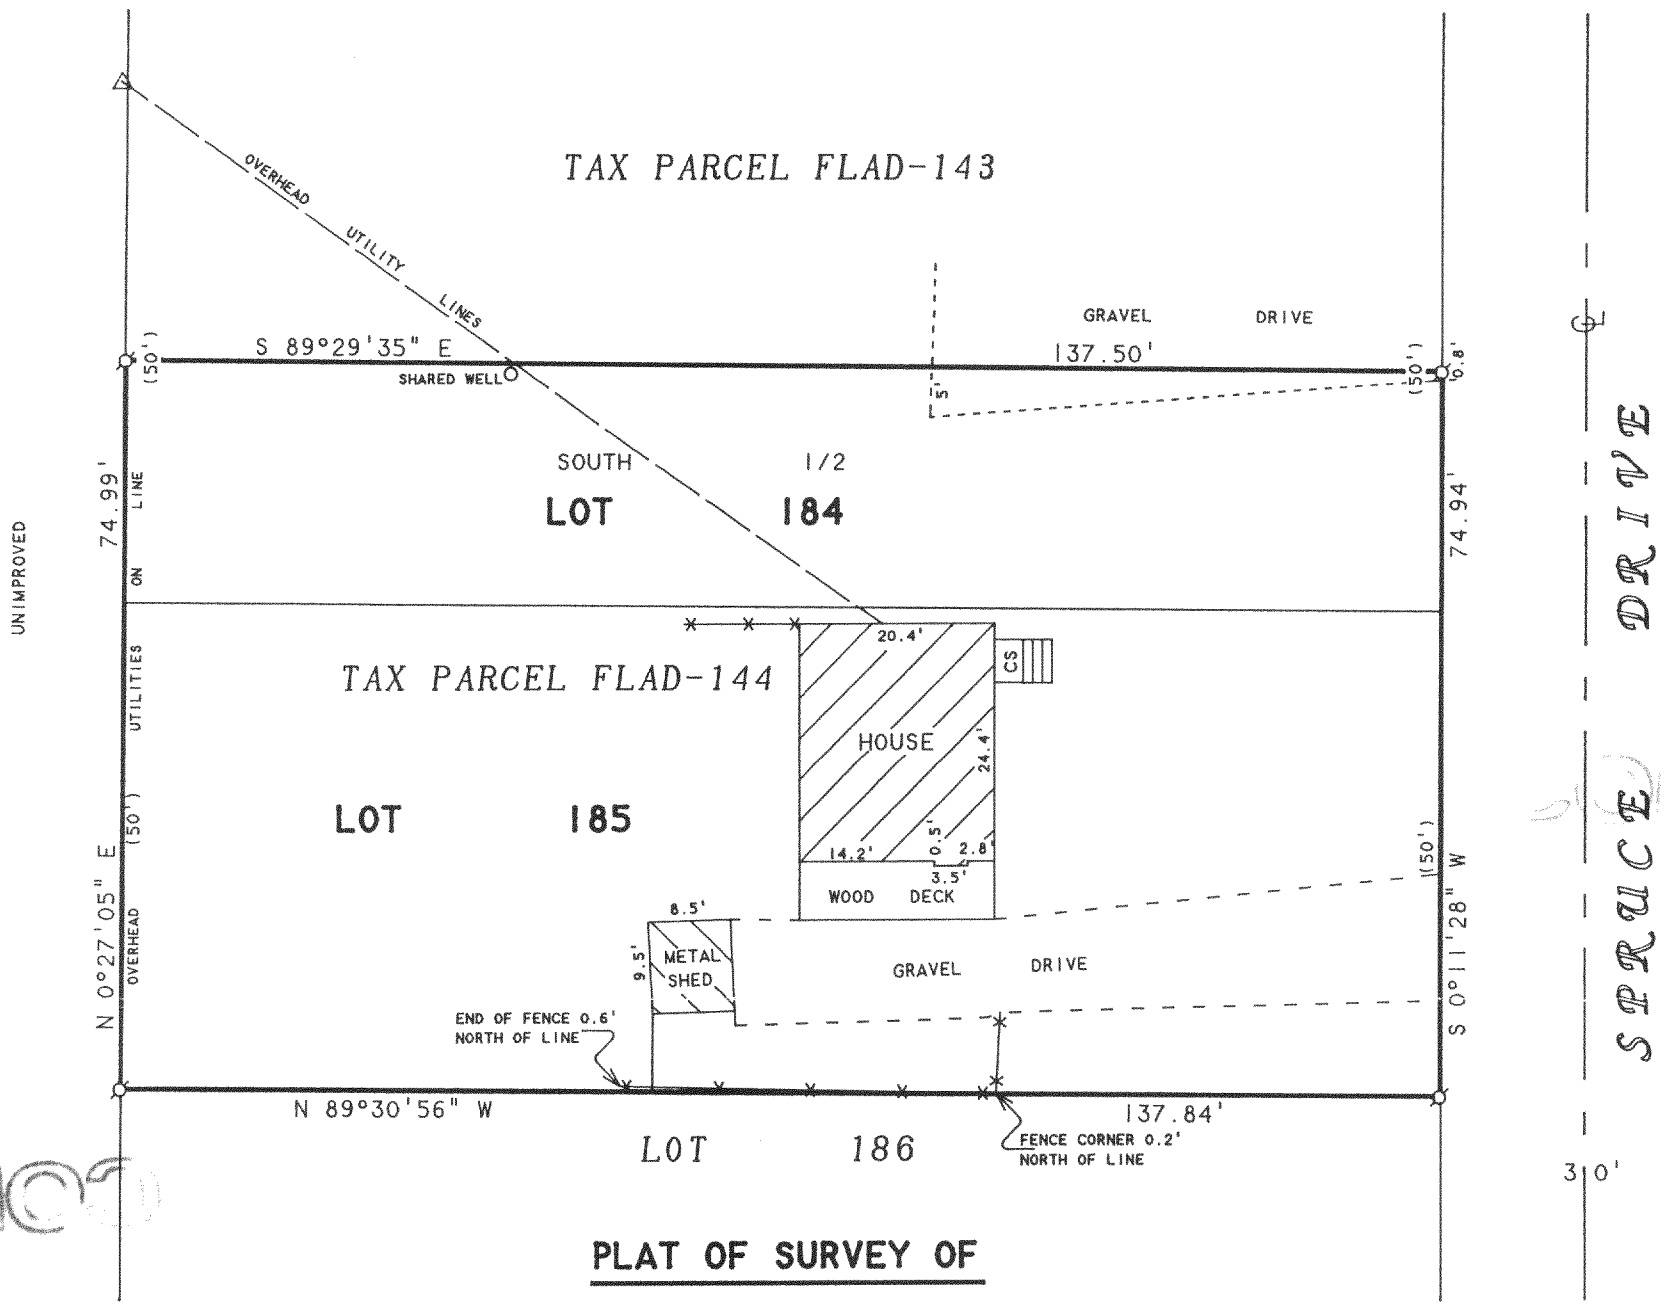

**PLAT OF SURVEY OF**

LOT 185 AND THE SOUTH 1/2 OF LOT 184, LAKE DELAVAN  
HIGHLANDS, T2N, R16E, WALWORTH COUNTY, WISCONSIN.  
CONTAINING 0.24 ACRES.

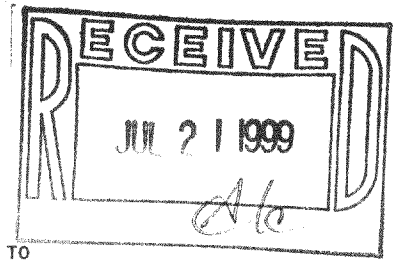

ORDERED BY: HIBL'S REAL ESTATE SALES, INC.  
10348 ANN STREET  
DELAVAN, WI 53115

NOTE: BEARINGS ARE REFERENCED TO  
EXISTING SURVEY RECORDS.



SCALE 1" = 20'

**LEGEND**

- - IRON PIPE FOUND
- \* - WOOD FENCE
- △ - UTILITY POLE
- CS - CONCRETE STOOP
- ( ) - RECORDED AS

I HEREBY CERTIFY THAT I HAVE SURVEYED THE ABOVE DESCRIBED PROPERTY AND THAT THE ABOVE MAP IS A TRUE REPRESENTATION THEREOF AND SHOWS THE SIZE AND LOCATION OF THE PROPERTY, ITS EXTERIOR BOUNDARIES, THE LOCATION OF ALL VISIBLE STRUCTURES AND DIMENSIONS OF ALL PRINCIPAL BUILDINGS THEREON, BOUNDARY FENCES, APPARENT EASEMENTS, ROADWAYS AND VISIBLE ENCROACHMENTS, IF ANY, TO THE BEST OF MY KNOWLEDGE AND BELIEF.

THIS SURVEY IS MADE FOR THE USE OF THE PRESENT OWNERS OF THE PROPERTY, AND ALSO THOSE WHO PURCHASE, MORTGAGE, OR GUARANTEE THE TITLE THERETO WITHIN ONE (1) YEAR FROM DATE HEREON.

*David F. Abell*

DAVID F. ABELL  
WISCONSIN REGISTERED LAND SURVEYOR, S-1596

June 14, 1999

DATE: \_\_\_\_\_ JOB NUMBER - 99092  
NOTE: THIS IS NOT A CERTIFIED COPY UNLESS SEALED.

216-2765  
FLAD-144