


1140 SEQUOIA STREET • DELAVAN, WISCONSIN 53115
414-728-6737

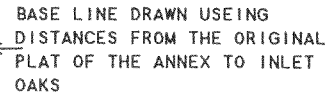


LOTS 6 AND 7, ANNEX TO INLET OAKS, LOCATED
IN T2N. R16E. WALWORTH COUNTY, WISCONSIN.

ORDERED BY: ERA CORNER REALTY
5362 STATE ROAD "11"
ELKHORN, WI 53121

David F. Hall

September 8, 1999

DATE _____ JOB NUMBER - 99145
NOTE: THIS IS NOT A CERTIFIED COPY UNLESS SEALED.

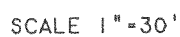

○ - IRON PIPE FOUND
 ● - 3/4" DIA. IRON ROD SET
 ● - 7/8" DIA. IRON ROD SET
 () - RECORDED AS



216-2794