



# PLAT OF SURVEY

**PATHFINDER SURVEYING**  
 FORMERLY KOLB LAND CONSULTING  
 929 WILLIAMS STREET LAKE GENEVA, WI. 53147  
 (262)- 248-3697


DATE: 12-21-1999

ORDERED BY: JAY GAUTHIER ATTORNEY AT LAW  
 400 E RANDOLPH STE. 3416  
 CHICAGO, IL 60601

DESCRIPTION: THE WEST HALF OF LOT 1 OF SIDON SUBDIVISION SITUATED IN SECTION 28, TOWN 2 NORTH, RANGE 16 EAST, TOWN OF DELAVAN, WALWORTH COUNTY WISCONSIN.  
 ALSO INCLUDING AND EASEMENT FOR INGRESS AND EGRESS ACROSS THE EXTREME SOUTHWEST CORNER OF THE EAST ONE HALF OF LOT 1 OF SIDON SUBDIVISION. SUBJECT TO THE TERMS AND CONDITIONS CONDITIONS OF EASEMENT AGREEMENT RECORDED OCTOBER 31, 1988 IN WALWORTH COUNTY REGISTER DEEDS OFFICE IN VOLUME 443, PAGE 528 AS DOCUMENT # 170150

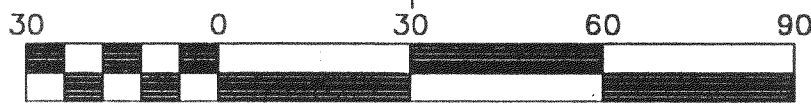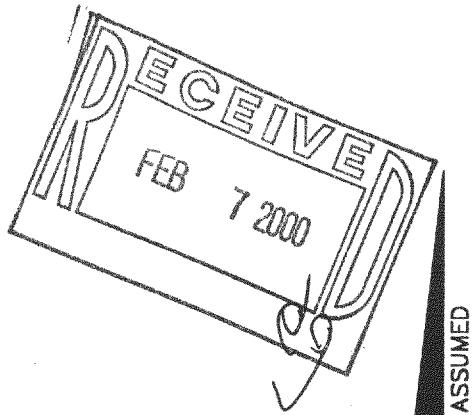

Scale 1" = 30'

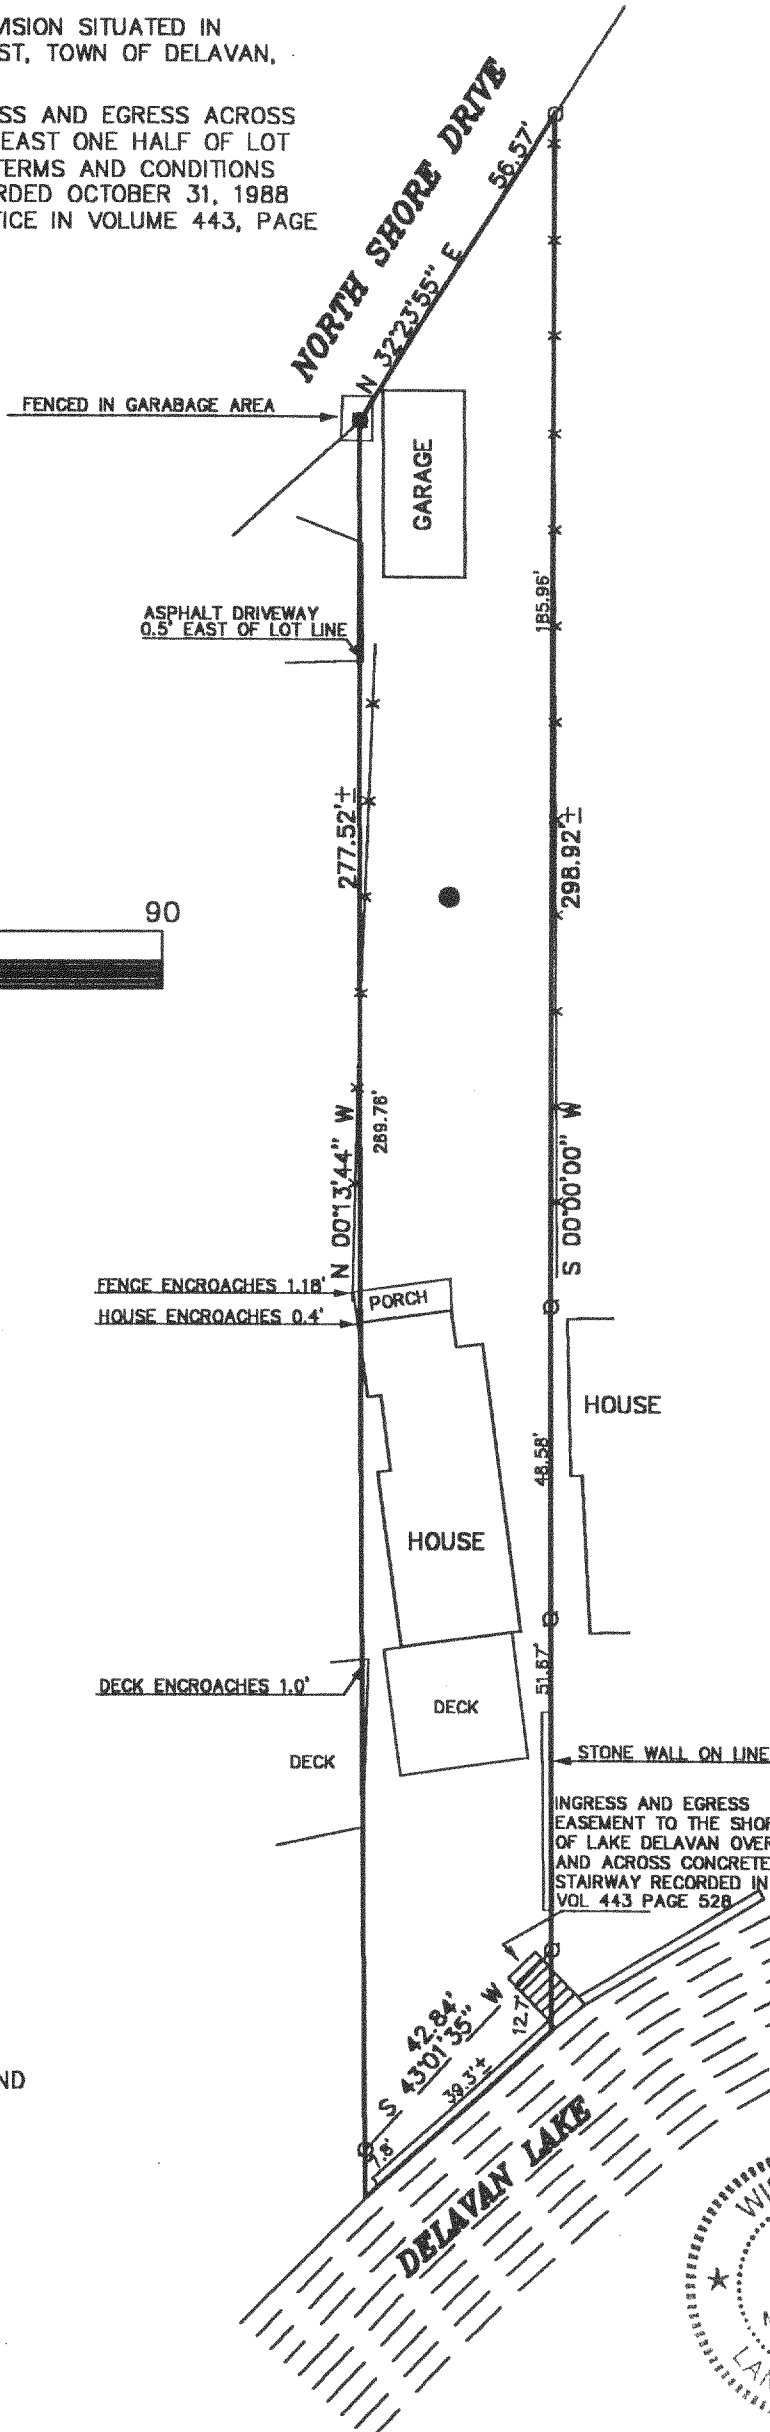

- LEGEND
- ⊙ FOUND IRON PIPE
  - FOUND IRON PIN
  - (XXXXX) RECORDED AS
  - X- FENCE
  - WELL

THE ABOVE MAP IS A TRUE REPRESENTATION THEREOF AND SHOWS THE SIZE AND LOCATION OF ALL THE PROPERTY, EXTERIOR BOUNDARIES, THE LOCATION OF ALL VISIBLE BOUNDARY FENCES, APPARENT EASEMENTS, ROADWAYS AND VISIBLE ENCROACHMENTS, IF ANY

THIS SURVEY IS MADE FOR THE USE OF THE PRESENT OWNERS OF THE PROPERTY, AND ALSO THOSE WHO PURCHASE, MORTGAGE OR GURANTEE TITLE THERETO WITHIN ONE (1) YEAR FROM DATE HERETO.

*John P. Krott*  
 JOHN P. KROTT, R.L.S. 2258



NOTE: THIS IS NOT A CERTIFIED COPY UNLESS SEAL IS IN RED.  
 JOB NUMBER #99297 FSI 0002

216-2834 FSI-2