


ABELL  
SURVEYING & MAPPING

1140 SEQUOIA STREET • DELAVAN, WISCONSIN 53115  
262-728-6737



DELANAN LAKE

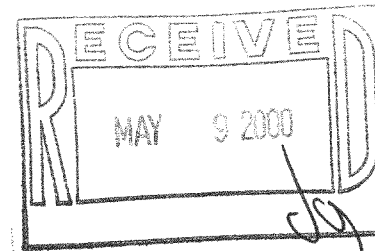

SCALE 1"=30'

LEGEND

- - IRON PIPE FOUND
- - CONCRETE MONUMENT FOUND
- WP - WOOD PORCH
- \* - CHAINLINK FENCE
- ⊗ MH - MANHOLE COVER
- ( ) - RECORDED AS

NOTE: BEARINGS ARE REFERENCED TO THE  
RECORDED SUBDIVISION PLAT.

I, DAVID F. ABELL, DO HEREBY CERTIFY THAT I HAVE SURVEYED THE PROPERTY HEREON  
DESCRIBED ACCORDING TO THE OFFICAL RECORDS AND THAT THE PLAT HEREON IS A  
CORRECT REPRESENTATION OF THE PROPERTY LINES TO THE BEST OF MY KNOWLEDGE AND  
BELIEF.

*David F. Abell*

DAVID F. ABELL  
WISCONSIN REGISTERED LAND SURVEYOR, S-1596

June 7, 1999

DATE JOB NUMBER - 99058B  
NOTE: THIS IS NOT A CERTIFIED COPY UNLESS SEALED.

REVISED DATE: NOVEMBER 29, 1999  
REVISED TO SHOW PROPOSED HOUSE LOCATION

REVISED DATE: MARCH 1, 2000  
REVISED TO SHOW HOUSE UNDER CONSTRUCTION

REVISED DATE: APRIL 4, 2000  
REVISED TO SHOW CORRECTED ROAD NAME

ORDERED BY: KIM W. O'KEEFE  
2336 NORTH SHORE DRIVE  
DELAVAN, WI 53115

LOT 3

AS SURVEYED BY H. KOLB JUNE 16, 1965 AND SEPT. 5, 1974, REVISED FEBRUARY 17, 1975

LOT 4

AREA 0.42 ACRES ±

AS SURVEYED BY G. DUNHAM MAY 15, 1968

PLAT OF SURVEY OF

LOT 4, MEACHAM'S PARK, LOCATED IN T2N, R16E,  
WALWORTH COUNTY, WISCONSIN.

LOT 5

HOUSE UNDER  
CONSTRUCTION  
3-1-00

SOUTH SHORE DRIVE

GARAGE

GRAVEL  
DRIVE

IRON PIPE FOUND BENT 1.28'  
SOUTH AND 1.25' WEST OF  
CORNER

FENCE CORNER 1.2'  
S.W. OF LINE

END OF FENCE 0.4'  
N.E. OF LINE

FENCE 0.1'  
N.E. OF LINE

END OF FENCE 0.2'  
N.E. OF LINE

APPROXIMATE CENTERLINE  
SANITARY SEWER EASEMENT

MH