

ABELL
SURVEYING & MAPPING

1140 SEQUOIA STREET • DELAVAN, WISCONSIN 53115
262-728-6737




SCALE 1"=20'

LEGEND

- ⊙ - IRON PIPE FOUND
- - 3/4" DIA. IRON ROD SET
- - UTILITY PED.
- △ - UTILITY POLE
- () - RECORDED AS


NOTE: BEARINGS ARE REFERENCED TO
EXISTING SURVEY RECORDS.

BEACH AVENUE

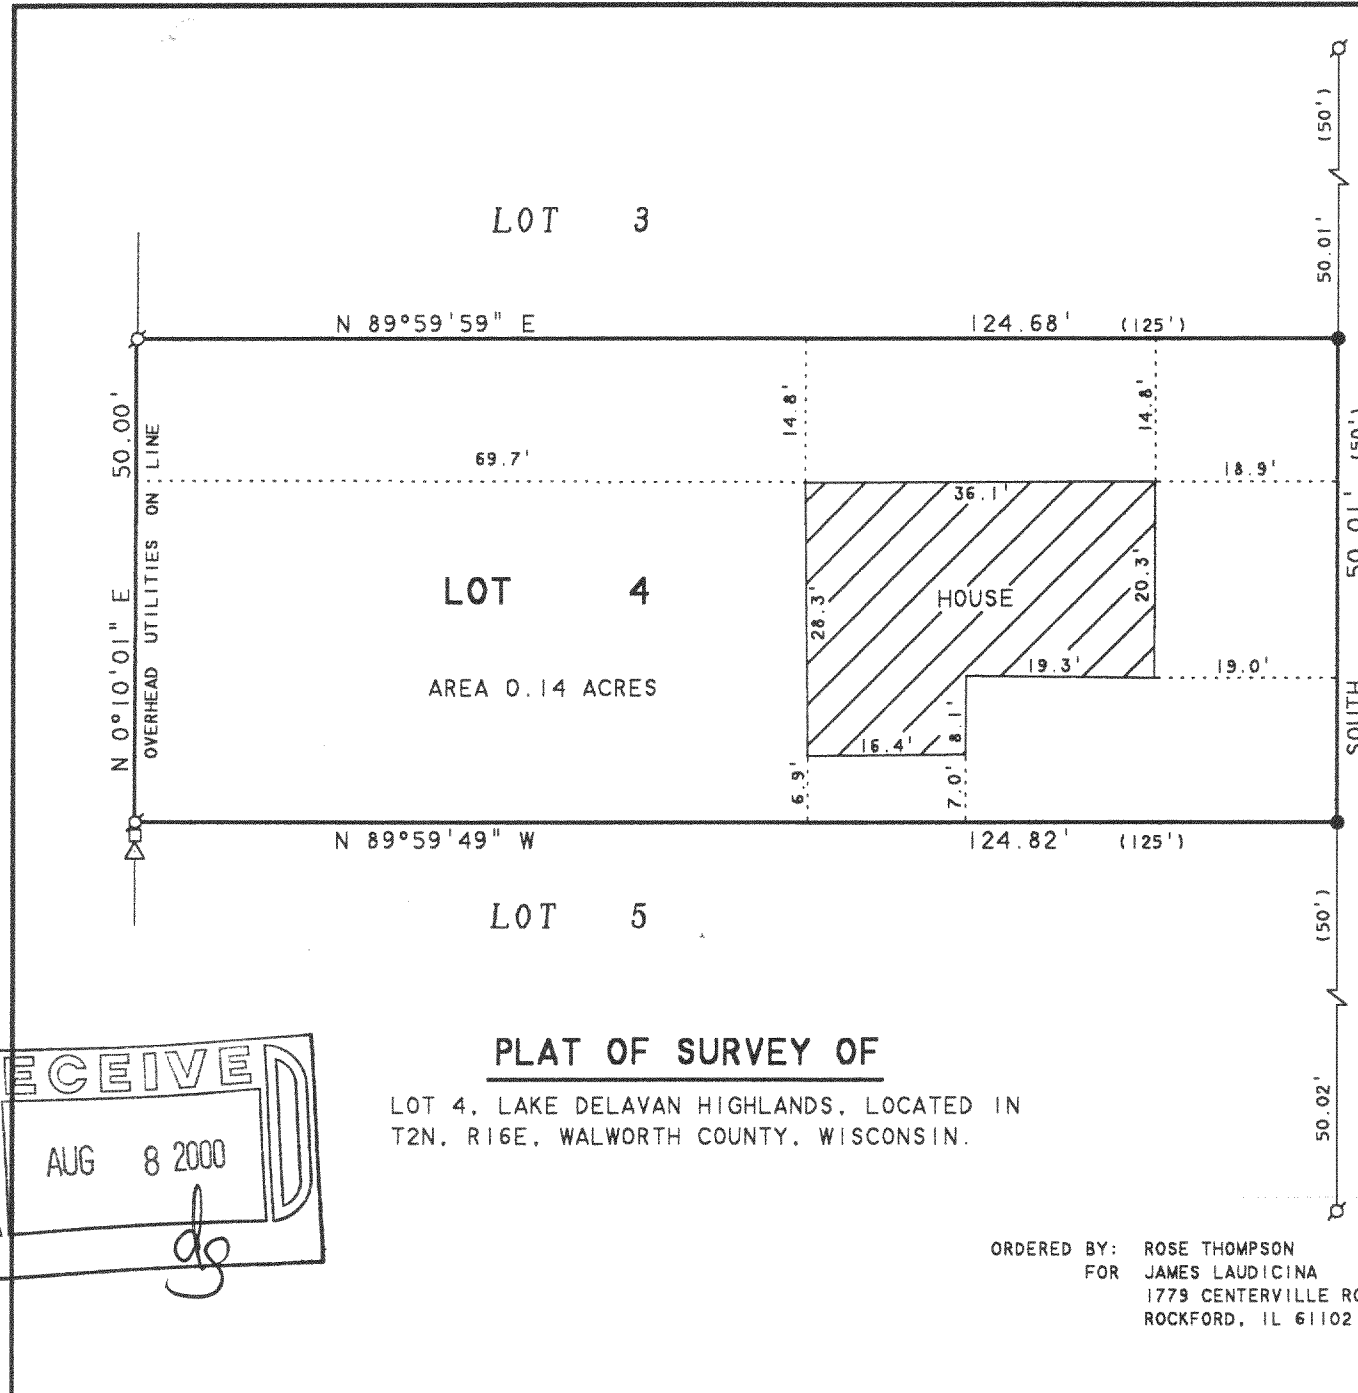

PLAT OF SURVEY OF

LOT 4, LAKE DELAVAN HIGHLANDS, LOCATED IN
T2N. R16E. WALWORTH COUNTY, WISCONSIN.

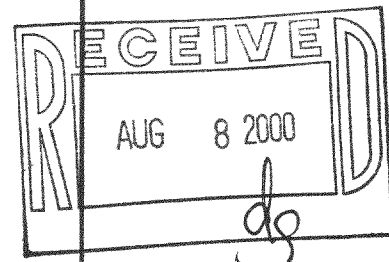

ORDERED BY: ROSE THOMPSON
FOR: JAMES LAUDICINA
1779 CENTERVILLE ROAD
ROCKFORD, IL 61102

I, DAVID F. ABELL, DO HEREBY CERTIFY THAT I HAVE SURVEYED THE PROPERTY HEREON DESCRIBED ACCORDING TO THE OFFICAL RECORDS AND THAT THE PLAT HEREON IS A CORRECT REPRESENTATION OF THE PROPERTY LINES TO THE BEST OF MY KNOWLEDGE AND BELIEF.

David F. Abell

DAVID F. ABELL
WISCONSIN REGISTERED LAND SURVEYOR, S-1596

July 13, 2000

DATE: July 13, 2000 JOB NUMBER - 00103
NOTE: THIS IS NOT A CERTIFIED COPY UNLESS SEALED.

FLAD-3

216-2885