


1140 SEQUOIA STREET • DELAVAN, WISCONSIN 53115
262-728-6737

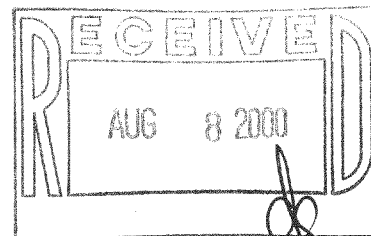

LOTS 11 AND 12; ROBBINS SUBDIVISION, LOCATED
IN T2N, R16E, WALWORTH COUNTY, WISCONSIN

SCALE 1"=20'

LEGEND

- ♂ - IRON PIPE FOUND
 ○ - 1" DIA. IRON PIPE SET
 -XX- - CHAINLINK FENCE
 △ - UTILITY POLE
 □ - UTILITY PED.
 () - RECORDED AS

I HEREBY CERTIFY THAT I HAVE SURVEYED THE ABOVE DESCRIBED PROPERTY AND THAT THE ABOVE MAP IS A TRUE REPRESENTATION THEREOF AND SHOWS THE SIZE AND LOCATION OF THE PROPERTY, ITS EXTERIOR BOUNDARIES, THE LOCATION OF ALL VISIBLE STRUCTURES AND DIMENSIONS OF ALL PRINCIPAL BUILDINGS THEREON, BOUNDARY FENCES, APPARENT EASEMENTS, ROADWAYS AND VISIBLE ENCROACHMENTS, IF ANY, TO THE BEST OF MY KNOWLEDGE AND BELIEF.

THIS SURVEY IS MADE FOR THE USE OF THE PRESENT OWNERS OF THE PROPERTY, AND ALSO THOSE WHO PURCHASE, MORTGAGE, OR GUARANTEE THE TITLE THERETO WITHIN ONE (1) YEAR FROM DATE HEREON.

DAVID F. ABELL
WISCONSIN REGISTERED LAND SURVEYOR, S-1596

ORDERED BY: SECURITY TITLE COMPANY
25 N. WISCONSIN
ELKHORN, WI 53121

DATE _____ JOB NUMBER - 00102
NOTE: THIS IS NOT A CERTIFIED COPY UNLESS SEALED.

FR0-33

216-2912