

1140 SEQUOIA STREET • DELAVAN, WISCONSIN 53115  
262-728-6737

LOT 25, FIRST ADDITION TO LAKEWOOD  
ESTATES, LOCATED IN T2N, R16E,  
WALWORTH COUNTY, WISCONSIN.

LOT 25  
AREA 0.63 ACRES

IRON PIPE FOUND LEANING  
0.14' NORTH AND 0.26' —  
WEST OF CORNER

NOTE: BEARINGS ARE REFERENCED TO THE  
RECORDED SUBDIVISION PLAT.

SCALE 1" = 30'

### LEGEND

- Ø - IRON PIPE FOUND  
 CP - CONCRETE PORCH  
 □ □ - UTILITY PEDS.  
 ▲ - YARD LIGHT  
 ( ) - RECORDED AS

I HEREBY CERTIFY THAT I HAVE SURVEYED THE ABOVE DESCRIBED PROPERTY AND THAT THE ABOVE MAP IS A TRUE REPRESENTATION THEREOF AND SHOWS THE SIZE AND LOCATION OF THE PROPERTY, ITS EXTERIOR BOUNDARIES, THE LOCATION OF ALL VISIBLE STRUCTURES AND DIMENSIONS OF ALL PRINCIPAL BUILDINGS THEREON, BOUNDARY FENCES, APPARENT EASEMENTS, ROADWAYS AND VISIBLE ENCROACHMENTS, IF ANY, TO THE BEST OF MY KNOWLEDGE AND BELIEF.

THIS SURVEY IS MADE FOR THE USE OF THE PRESENT OWNERS OF THE PROPERTY, AND ALSO THOSE WHO PURCHASE, MORTGAGE, OR GUARANTEE THE TITLE THERETO WITHIN ONE (1) YEAR FROM DATE HEREON.


Daniel F. Ball

DAVID F. ABELL  
WISCONSIN REGISTERED LAND SURVEYOR, S-1596

ORDERED BY: KEEFE REAL ESTATE  
1155 E. GENEVA STREET  
DELAVER, WI 53115

September 6, 2000

DATE \_\_\_\_\_ JOB NUMBER - 00143  
NOTE: THIS IS NOT A CERTIFIED COPY UNLESS SEALED.

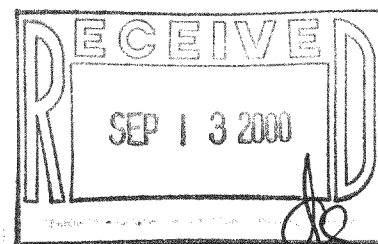

FLEA-5

216-2926