


**FARRIS, HANSEN, & ASSOCIATES, INC.**  
 ENGINEERING, ARCHITECTURE, SURVEYING  
 7 RIDGWAY COURT - P.O. BOX 437, ELKHORN, WISCONSIN, 53121  
 PHONE: (414) 723-2098 FAX: (414) 723-5886  
 PLAT OF SURVEY

LOT 8 OF SUNSET ACRES SUBDIVISION  
 LOCATED IN PART OF THE NE 1/4  
 OF SECTION 9, TOWN 2 NORTH, RANGE 16 EAST,  
 TOWN OF DELAVAN, WALWORTH COUNTY, WISCONSIN

- WORK ORDERED BY -  
 ROBERT BOUTELLE  
 642 HOLLAND AVE  
 DELAVAN, WI. 53115


- = FOUND IRON PIPE STAKE
- = SET IRON REBAR STAKE
- = FOUND IRON REBAR STAKE
- (xxx) = RECORDED AS

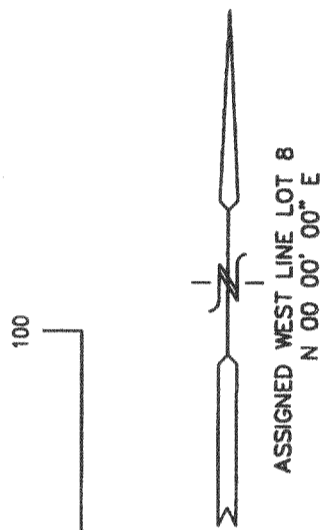

MAP SCALE IN FEET ORIGINAL 1" = 40'



SUNSET DRIVE  
66' WIDE ROW

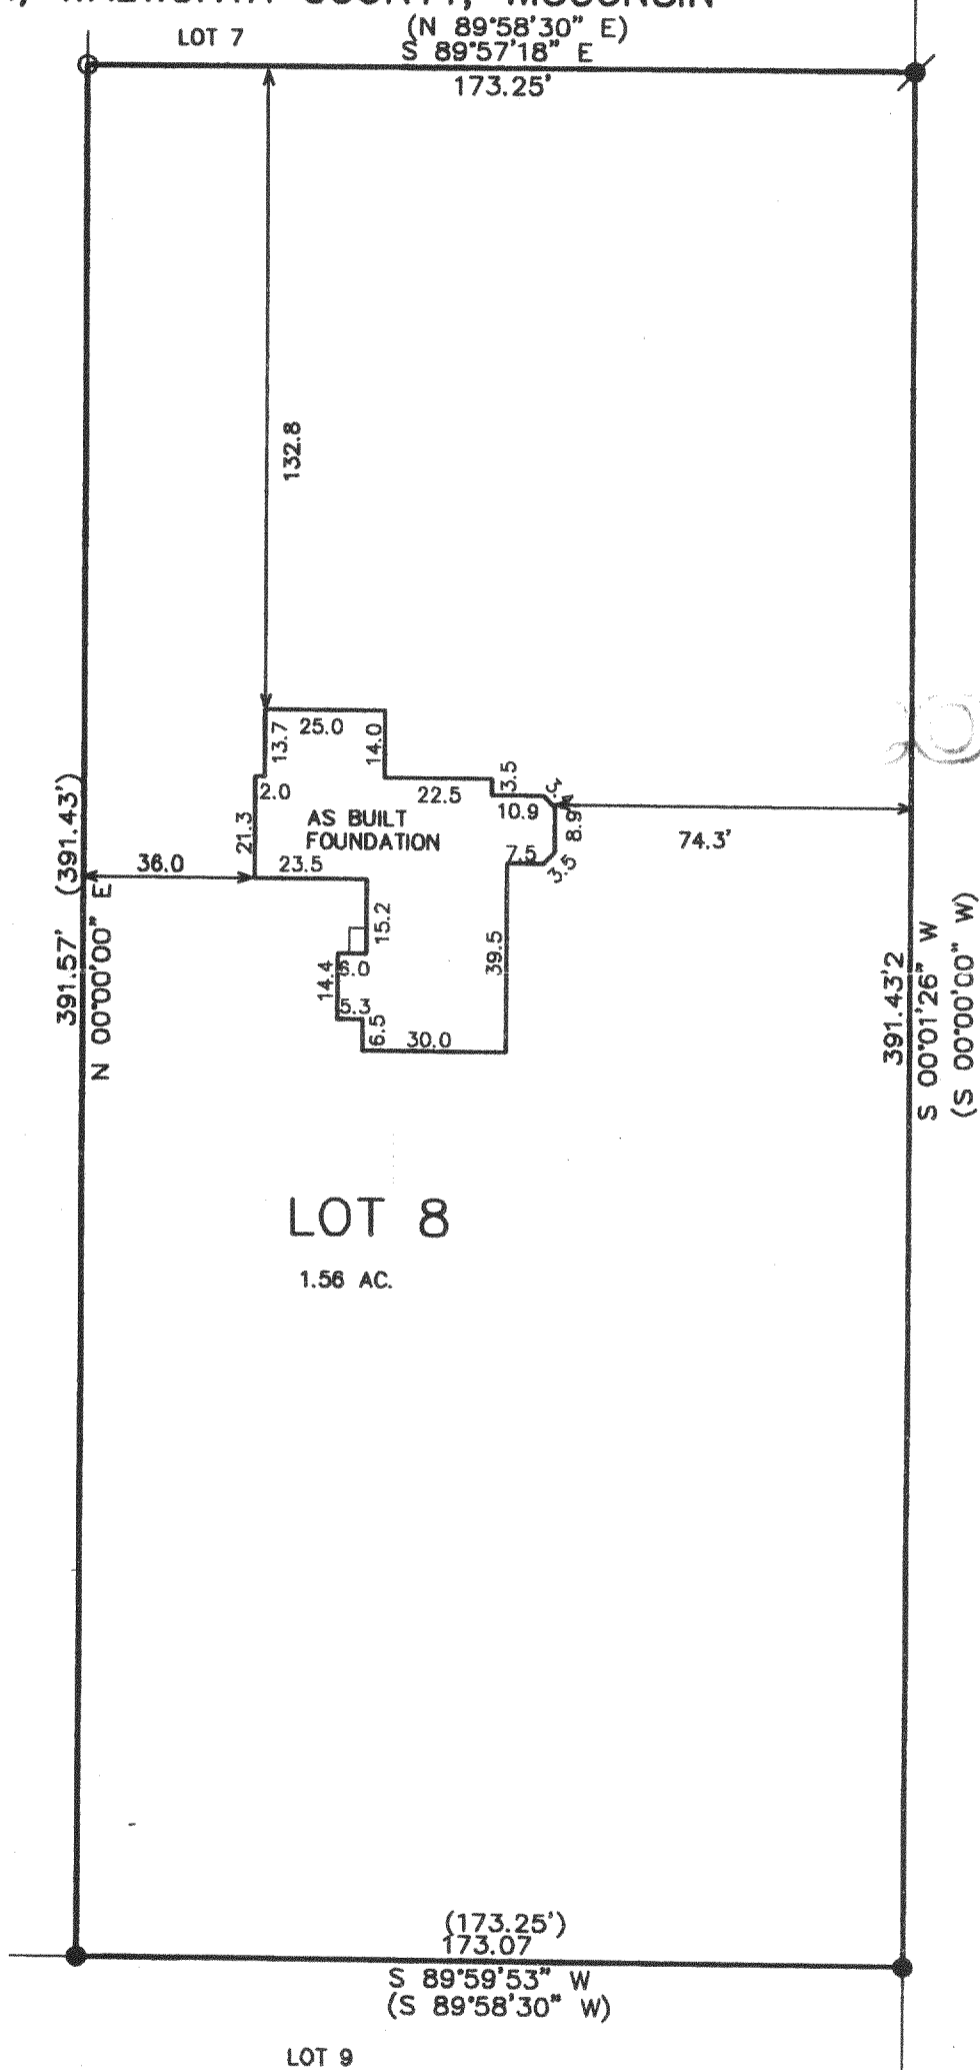

BOBA

NOTE: COPIES OF THIS MAP TO WHICH THE FOLLOWING CERTIFICATE WILL APPLY SHOW SURVEYOR'S ORIGINAL SEAL AND SIGNATURE IN RED INK. COPIES BY ANY OTHER MEANS MAY HAVE ALTERATIONS WHICH DO NOT REPRESENT THE SURVEYOR'S WORK PRODUCT.


I HEREBY CERTIFY THAT THE ABOVE DESCRIBED PROPERTY HAS BEEN SURVEYED UNDER MY DIRECTION AND THAT THE ABOVE MAP IS A TRUE REPRESENTATION THEREOF AND SHOWS THE SIZE AND LOCATION OF THE PROPERTY AND ITS EXTERIOR BOUNDARIES. THIS SURVEY IS MADE FOR THE USE OF THE PRESENT OWNERS OF THE PROPERTY, AND ALSO THOSE WHO PURCHASE, MORTGAGE, OR GUARANTEE THE TITLE THERETO WITHIN ONE YEAR FROM THE DATE HEREOF.

DATED: 07-18-2000

*Peter S. Gordon*  
 PETER S. GORDON R.L.S. 2101

*Revised  
 9/16/2000 to show  
 AS BUILT FOUNDATION*

PROJECT 5643  
 DATE: 07-17-2000  
 SHEET 1 OF 1

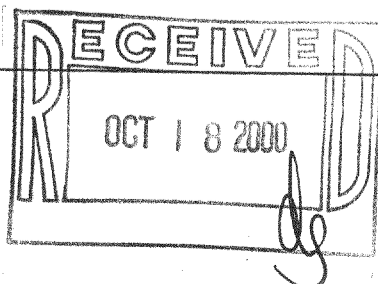

SEP 06 2000

FSUA-8

216-2941