

Y900

ABELL SURVEYING & MAPPING

1140 SEQUOIA STREET • DELAVAN, WISCONSIN 53115
262-728-6737

STREET

CHESTNUT

(WALNUT AVENUE)


LOT 266

124.80' (125')

LOT 265

GRAVEL DRIVE

0.29 ACRES

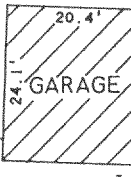

HOUSE UNDER
CONSTRUCTION
9/21/00

LOT 264

124.79' (125')

LOT 263

PLAT OF SURVEY OF

LOTS 264 AND 265, LAKE DELAVAN HIGHLANDS,
LOCATED IN T2N.R16E, WALWORTH COUNTY,
WISCONSIN.


ORDERED BY: CENTURY 21-SKANDIA REALTY
822 E. GENEVA STREET
DELAVAN, WI 53115



SCALE 1"=30'

LEGEND

- - IRON PIPE FOUND
- - IRON ROD FOUND
- - 3/4" IRON ROD SET
- () - RECORDED AS

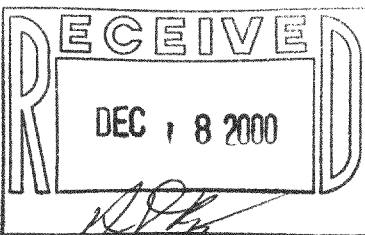

I HEREBY CERTIFY THAT I HAVE SURVEYED THE ABOVE DESCRIBED PROPERTY AND THAT THE ABOVE MAP IS A TRUE REPRESENTATION THEREOF AND SHOWS THE SIZE AND LOCATION OF THE PROPERTY, ITS EXTERIOR BOUNDARIES, THE LOCATION OF ALL VISIBLE STRUCTURES AND DIMENSIONS OF ALL PRINCIPAL BUILDINGS THEREON, BOUNDARY FENCES, APPARENT EASEMENTS, ROADWAYS AND VISIBLE ENCROACHMENTS, IF ANY, TO THE BEST OF MY KNOWLEDGE AND BELIEF.

THIS SURVEY IS MADE FOR THE USE OF THE PRESENT OWNERS OF THE PROPERTY, AND ALSO THOSE WHO PURCHASE, MORTGAGE, OR GUARANTEE THE TITLE THERETO WITHIN ONE (1) YEAR FROM DATE HEREON.

David F. Abell

DAVID F. ABELL
WISCONSIN REGISTERED LAND SURVEYOR, S-1596

REVISED: 9/21/00 TO SHOW HOUSE UNDER CONSTRUCTION

ORDERED BY: MARGARET DRWAL
10713 GEORGIA LANE
OAK LAWN, IL 60453

November 11, 1999

DATE: November 11, 1999 JOB NUMBER - 90211B
NOTE: THIS IS NOT A CERTIFIED COPY UNLESS SEALED.

Y900

FLAD-200

216-2955