
PLAT OF SURVEY

J.K. SURVEYING INC. N3705 WILLOWBEND LANE LAKE GENEVA, WI, 53147 262-248-3697

- OF -

LOT 22 OF THE GENEVA WEST ESTATES SUBDIVISION; A SUBDIVISION LOCATED IN THE SOUTHEAST 1/4 OF SECTION 25, TOWNSHIP 2 NORTH, RANGE 16 EAST, DELAVAN TOWNSHIP, WALWORTH COUNTY, WISCONSIN

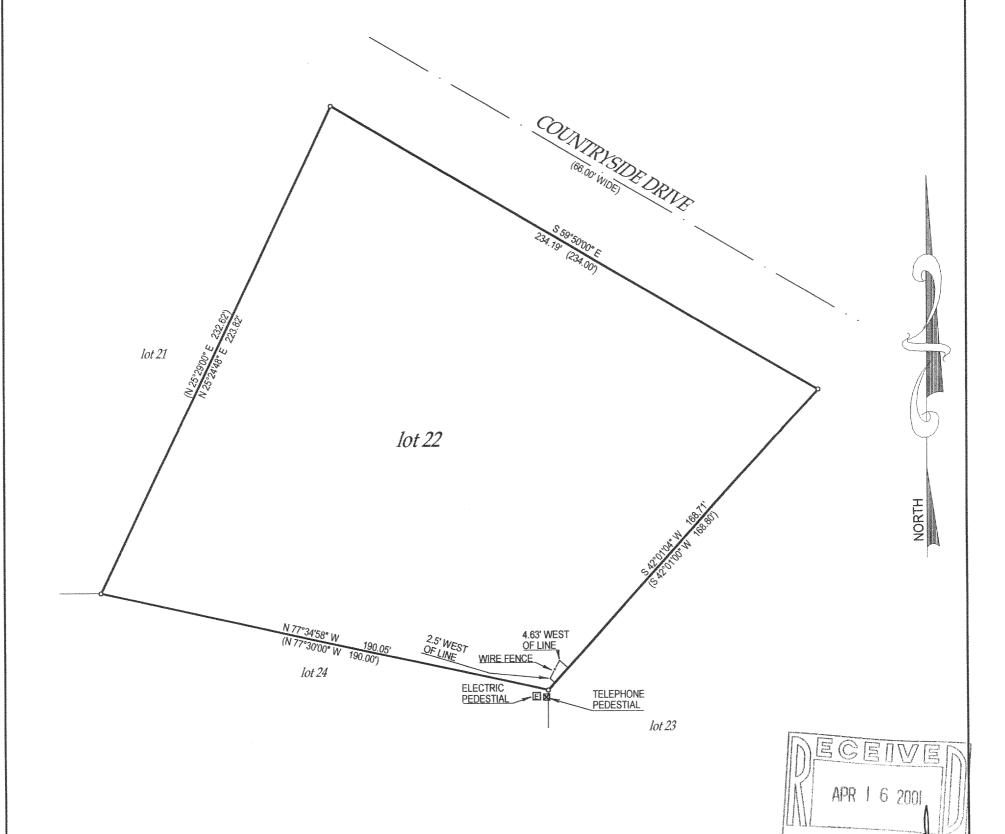

()= recorded as

□ = found iron bar

O = found iron pipe

= set iron pipe

= set iron bar

SCALE 1" = 40'

JOB #01-088

TAX ID #2-16-FGEW-22

COMPARE LEGAL DESCRIPTION ABOVE AND DRAWING WITH DEED. FOR BUILDING RESTRICTIONS AND EASEMENTS NOT SHOWN, REFER TO DEED, ABSTRACT SOURCES AND LOCAL MUNICIPAL CODES. NOTIFY THE SURVEYOR IMMEDIATELY OF ANY DISCREPANCY.

NOTE: BEARINGS REFERENCED TO THE RECORDED

PLAT OF GENEVA WEST ESTATES SUBDIVISION

"I hereby certify that I have surveyed the above described property and that the above map is a true representation thereof and shows the size and location of all visible structures, apparent easements and encroachments if any."

This survey is made for the present owners of the property, and those who purchase, mortgage, or guarantee the title thereto, within one year from the date hereof.

DATED THIS 28 TH, DAY OF MARCH



JOHN KROTT S - 2258 Wisconsin Registered Land Surveyor (original if signed in red)