
AUG 3 | 2001

ABELL SURVEYING & MAPPING

1140 SEQUOIA STREET • DELAVAN, WISCONSIN 53115 262-728-6737

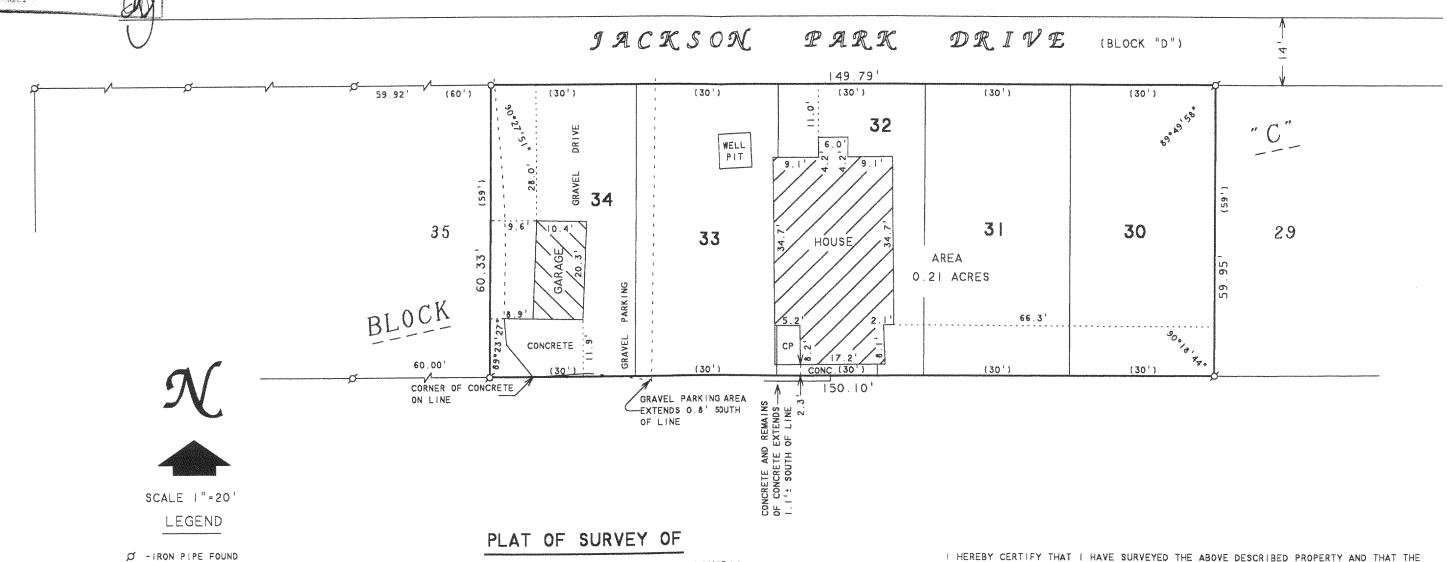

LOTS 30-34. BLOCK "C", JACKSON SUBDIVISION, LOCATED IN T2N, RIGE, WALWORTH COUNTY, WISCONSIN.

ORDERED BY: PAUL BUESSE

1771 FORESTVIEW DRIVE SYCAMORE, IL 60178 I HEREBY CERTIFY THAT I HAVE SURVEYED THE ABOVE DESCRIBED PROPERTY AND THAT THE ABOVE MAP IS A TRUE REPRESENTATION THEREOF AND SHOWS THE SIZE AND LOCATION OF THE PROPERTY. ITS EXTERIOR BOUNDARIES, THE LOCATION OF ALL VISIBLE STRUCTURES AND DIMENSIONS OF ALL PRINCIPAL BUILDINGS THEREON. BOUNDARY FENCES. APPARENT EASEMENTS, ROADWAYS AND VISIBLE ENCROACHMENTS, IF ANY. TO THE BEST OF MY KNOWLEDGE AND BELIEF.

THIS SURVEY IS MADE FOR THE USE OF THE PRESENT OWNERS OF THE PROPERTY, AND ALSO THOSE WHO PURCHASE, MORTGAGE, OR GUARANTEE THE TITLE THERETO WITHIN ONE (I) YEAR FROM DAYE HEREON.

Land t. Ma

DAVID F. ABELL WISCONSIN REGISTERED LAND SURVEYOR, S-1596

July 16, 200

DATE JOB NUMBER - 01097 NOTE: THIS IS NOT A CERTIFIED COPY UNLESS SEALED.

3 216-3054

O -1" DIA. IRON PIPE SET CP -CONCRETE PORCH

()-RECORDED AS

FJS-34

1 / Frank - 2