


216-3088 FLAD-3V

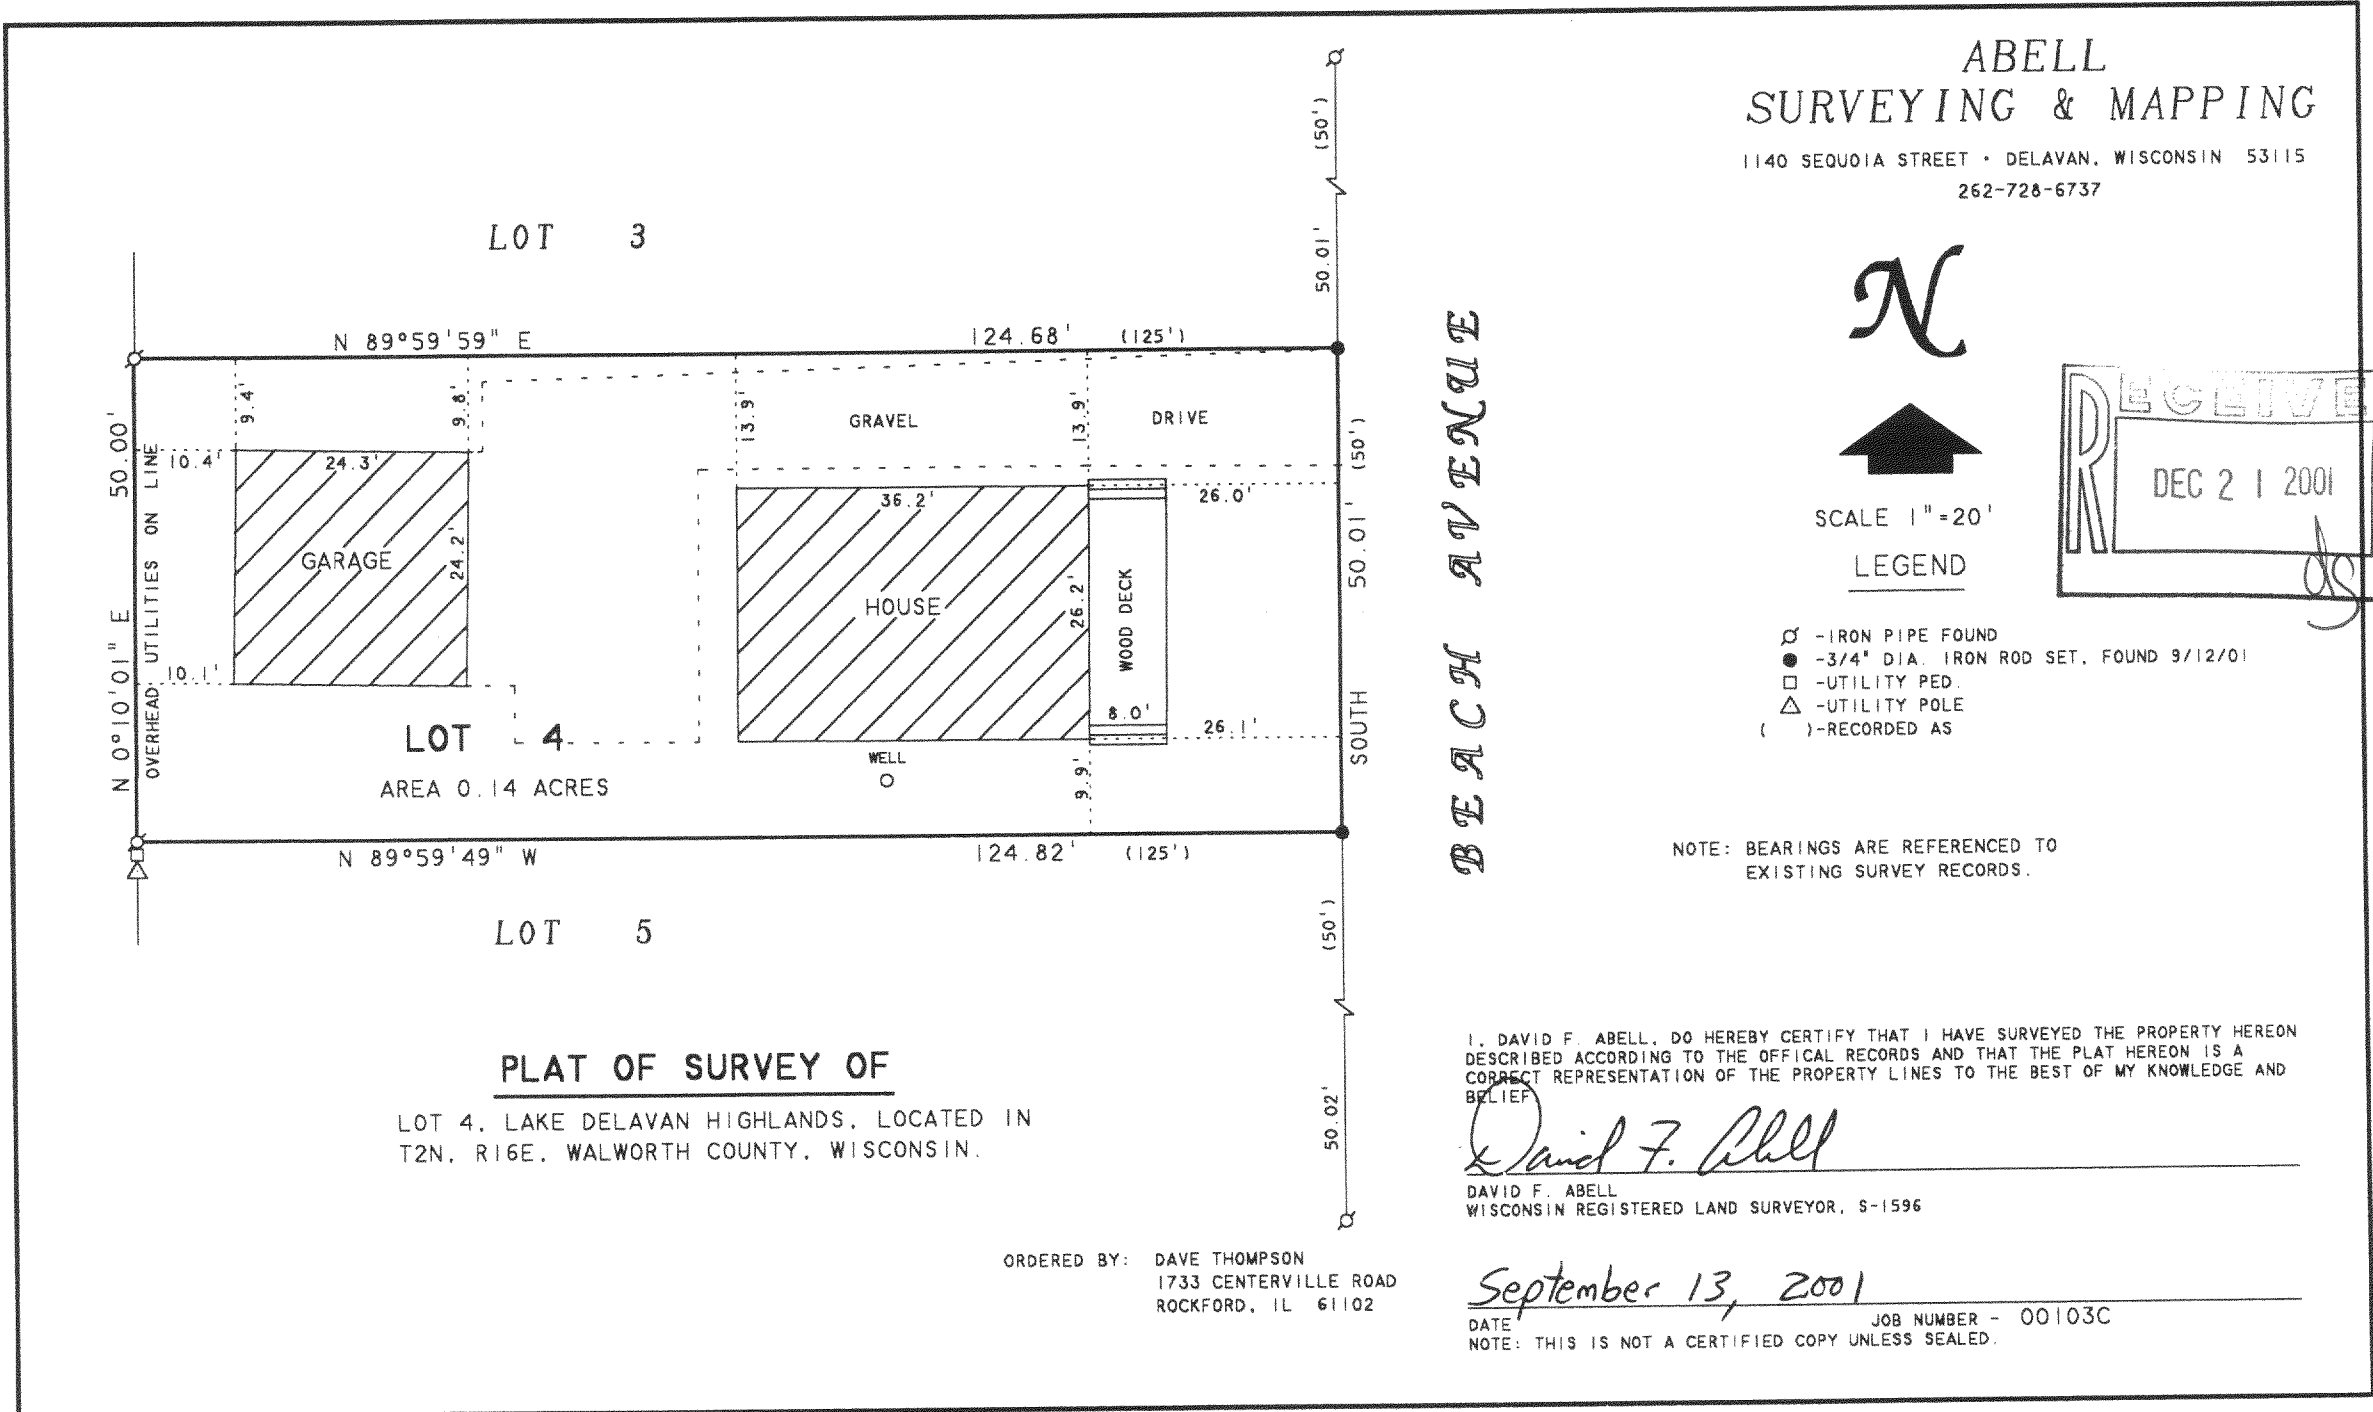

FLAD-3

216-3088