




PERPARED FOR :
SAM HARRISON

PLAT OF SURVEY

J.K. SURVEYING INC.
N3705 WILLOWBEND LANE
LAKE GENEVA, WI, 53147
262-248-3697

- OF -

LOT 4 WOOLAND SHORES, LOCATED IN T2N, R16E, WALWORTH COUNTY, WISCONSIN.
TOGETHER WITH A NON-EXCLUSIVE EASEMENT OVER AND ACROSS OUTLOT 1. WOODLAND SHORES
AS DESCRIBED ABOVE. WHICH LANDS BORDER DELAVAN LAKE OUTLET. PROVIDED HOWEVER, THAT
SAID EASEMENT SHALL TERMINATE AUTOMATICALLY IN THE EVENT EITHER OUTLOT 1 OR LOT 8 IN SAID
WOODLAND SHORES SUBDIVISION IS DEDICATED FOR PUBLIC LAKE ACCESS.

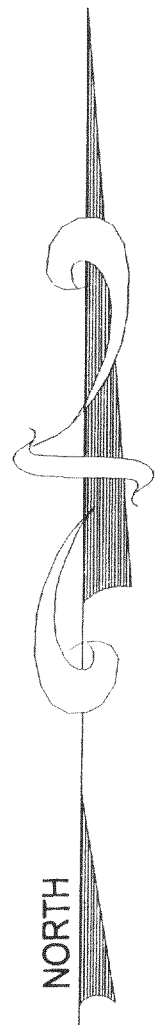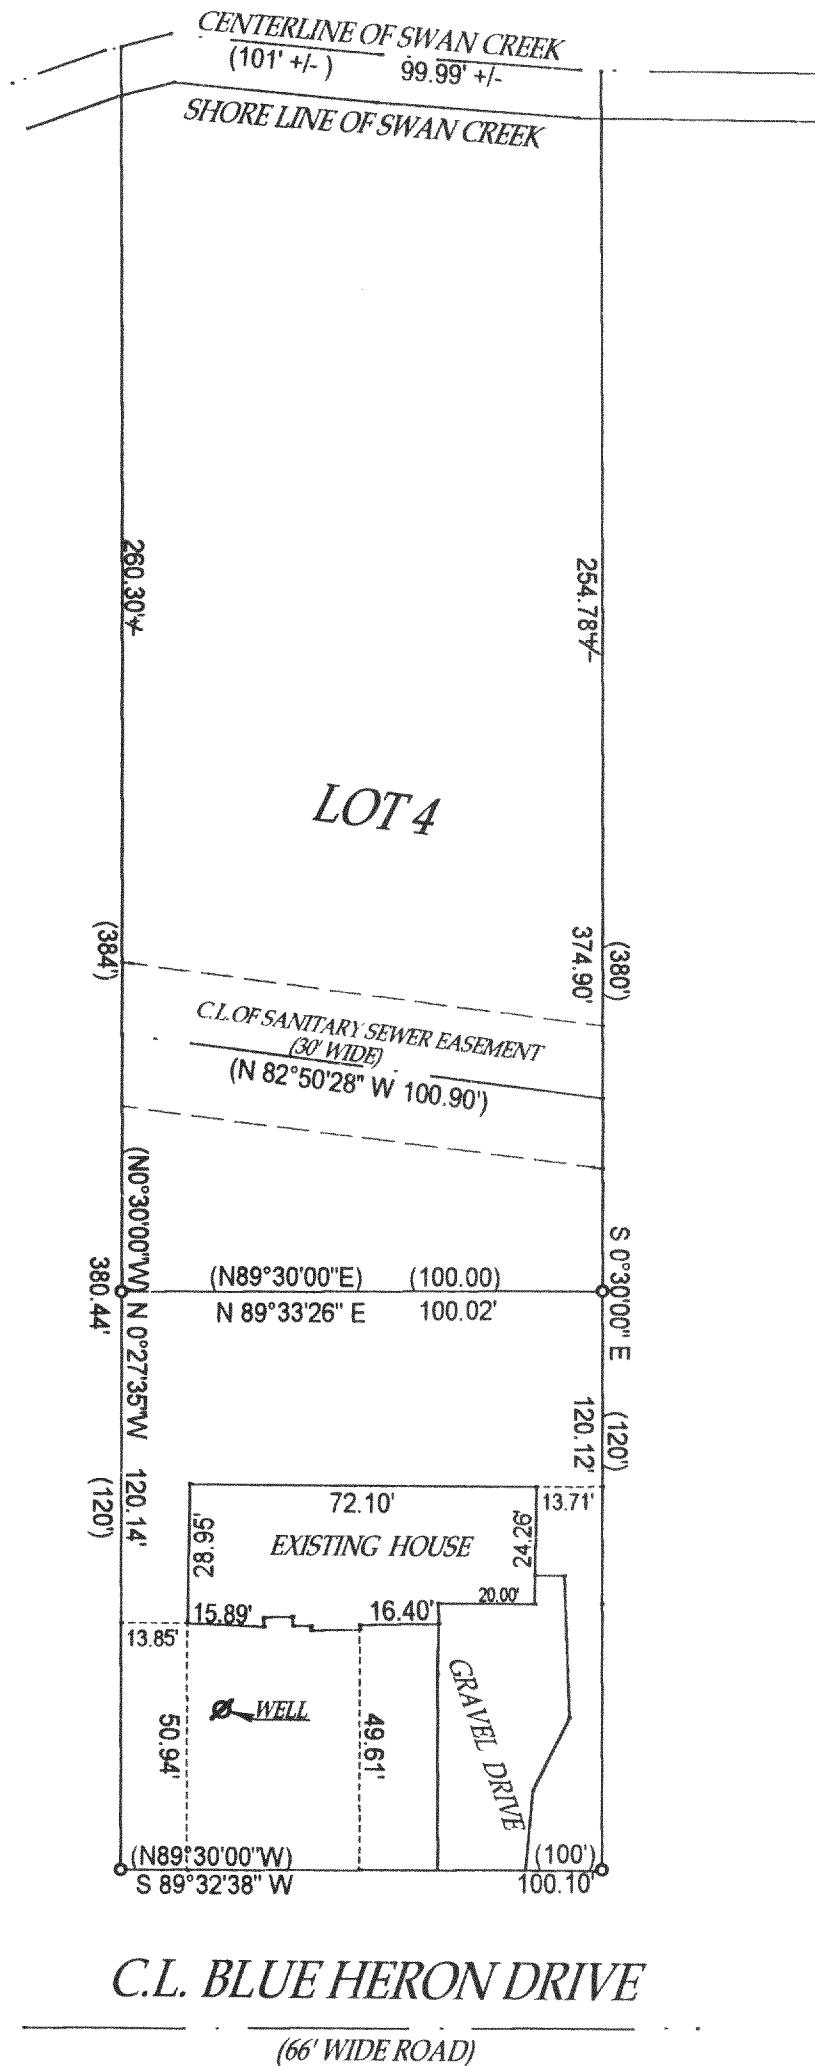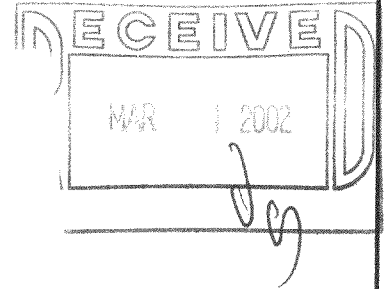


- () = recorded as
□ = found iron bar
○ = found iron pipe
● = set iron pipe
■ = set iron bar
SCALE 1" = 40'
JOB # 02-067
TAX ID # FWLS - 4

COMPARE LEGAL DESCRIPTION ABOVE AND DRAWING WITH DEED. FOR BUILDING RESTRICTIONS AND
EASEMENTS NOT SHOWN, REFER TO DEED, ABSTRACT SOURCES AND LOCAL MUNICIPAL CODES. NOTIFY
THE SURVEYOR IMMEDIATELY OF ANY DISCREPANCY.

"I hereby certify that I have surveyed the above described property and that
the above map is a true representation thereof and shows the size and
location of all visible structures, apparent easements and encroachments
if any."

This survey is made for the present owners of the property, and those who
purchase, mortgage, or guarantee the title thereto, within one year from
the date hereof.

DATED THIS 20 TH, DAY OF FEBRUARY 20 02

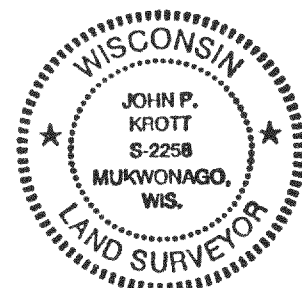

John P. Krott
JOHN KROTT S - 2258
Wisconsin Registered Land Surveyor
(original if signed in red)

FWLS-4 216-3138