P


PROJECT NO. 4932

DATE: 03/25/98 SHEET NO. 1 OF 1

PLAT OF SURVEY

LOT 10 OF POINT COMFORT ALSO PART OF PARK
LYING BETWEEN PLAT AND LAKE ROAD AND THAT PART
OF PARK LYING BETWEEN PLAT AND LAKE BY EXTENDING
NORTH AND SOUTH LINES

LOCATED IN SECTION 22, TOWN 2 NORTH, RANGE 16 EAST, WALWORTH COUNTY, WISCONSIN

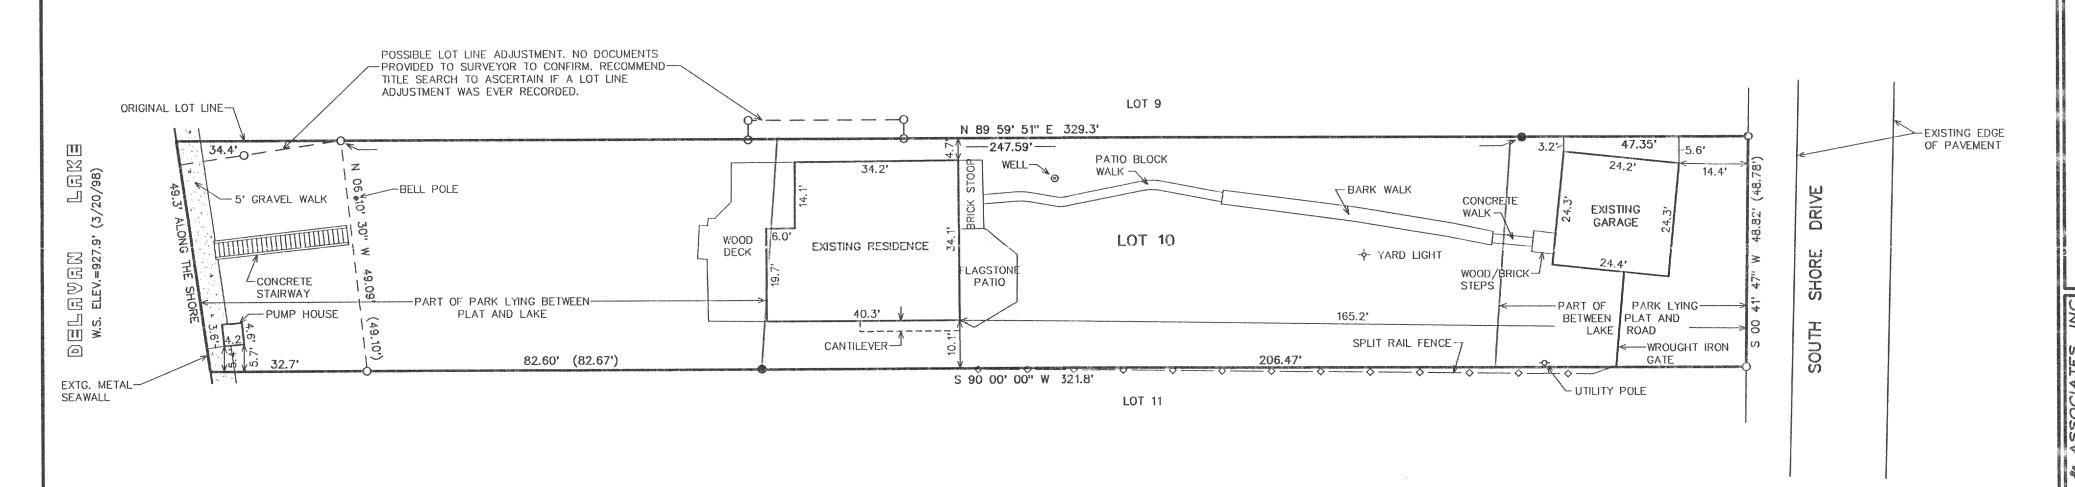

LEGEND

O = FOUND IRON PIPE STAKE

= FOUND IRON REBAR STAKE

(XXX) = RECORDED AS

10 5 0 10 20 30 40 50 60 70 80 90 100 MAP SCALE IN FEET ORIGINAL 1" = 20'

NOTE: COPIES OF THIS MAP TO WHICH THE FOLLOWING CERTIFICATE WILL APPLY SHOW THE SURVEYOR'S ORIGINAL SEAL AND SIGNATURE IN RED INK. COPIES BY ANY OTHER MEANS MAY HAVE ALTERATIONS WHICH DO NOT REPRESENT THE SURVEYOR'S WORK PRODUCT.

I HEREBY CERTIFY THAT THE ABOVE DESCRIBED PROPERTY HAS BEEN SURVEYED UNDER MY DIRECTION AND THAT THE ABOVE MAP IS A TRUE REPRESENTATION THEREOF AND SHOWS THE SIZE AND LOCATION OF THE PROPERTY AND ITS EXTERIOR BOUNDARIES. THIS SURVEY IS MADE FOR THE USE OF THE PRESENT OWNERS OF THE PROPERTY, AND ALSO THOSE WHO PURCHASE, MORTGAGE, OR GUARANTEE THE TITLE THERETO WITHIN ONE YEAR FROM THE DATE HEREOF.

3/25/98 DATED: _____ REVISED 4/16/02 TO SHOW EXISTING IMPROVEMENTS

PETER S. GORDON R.L.S. 2101

FPC-7, 216-3158