


ABERNATHY and ASSOCIATES

Kenneth B. Abernathy Jr.


Wisconsin Registered Land Surveyor S-1594

W4056 BRAY RD.
ELKHORN, WI. 53121
PHONE: (262) 723-4260 (OFFICE)
(262) 723-7209 (FAX)
Email: abernathy@elknet.net

PLAT OF SURVEY

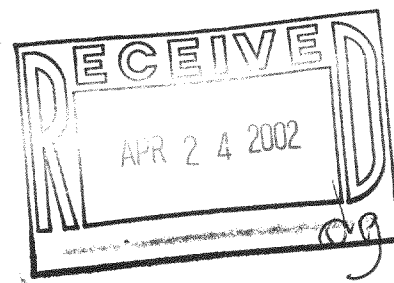


Lot 2 of Certified Survey Map Number 1971, as recorded in Volume 9 on Page 226 as Document Number 200820, being located in part of the Northeast 1/4 of the Northwest 1/4 of Section 2, Town 2 North, Range 16 East, Town of Delavan, Walworth County, Wisconsin.

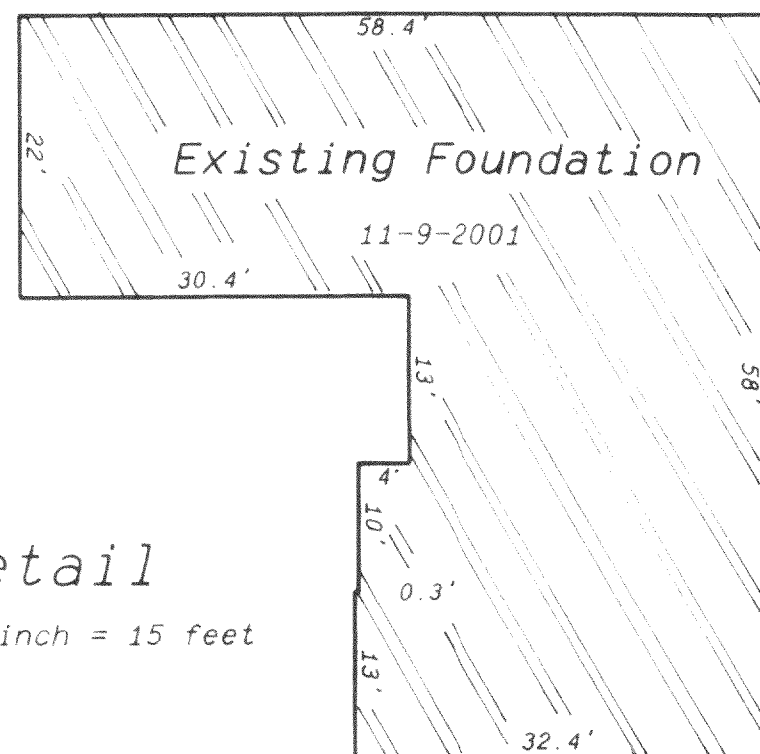

Detail


Scale: 1 inch = 15 feet

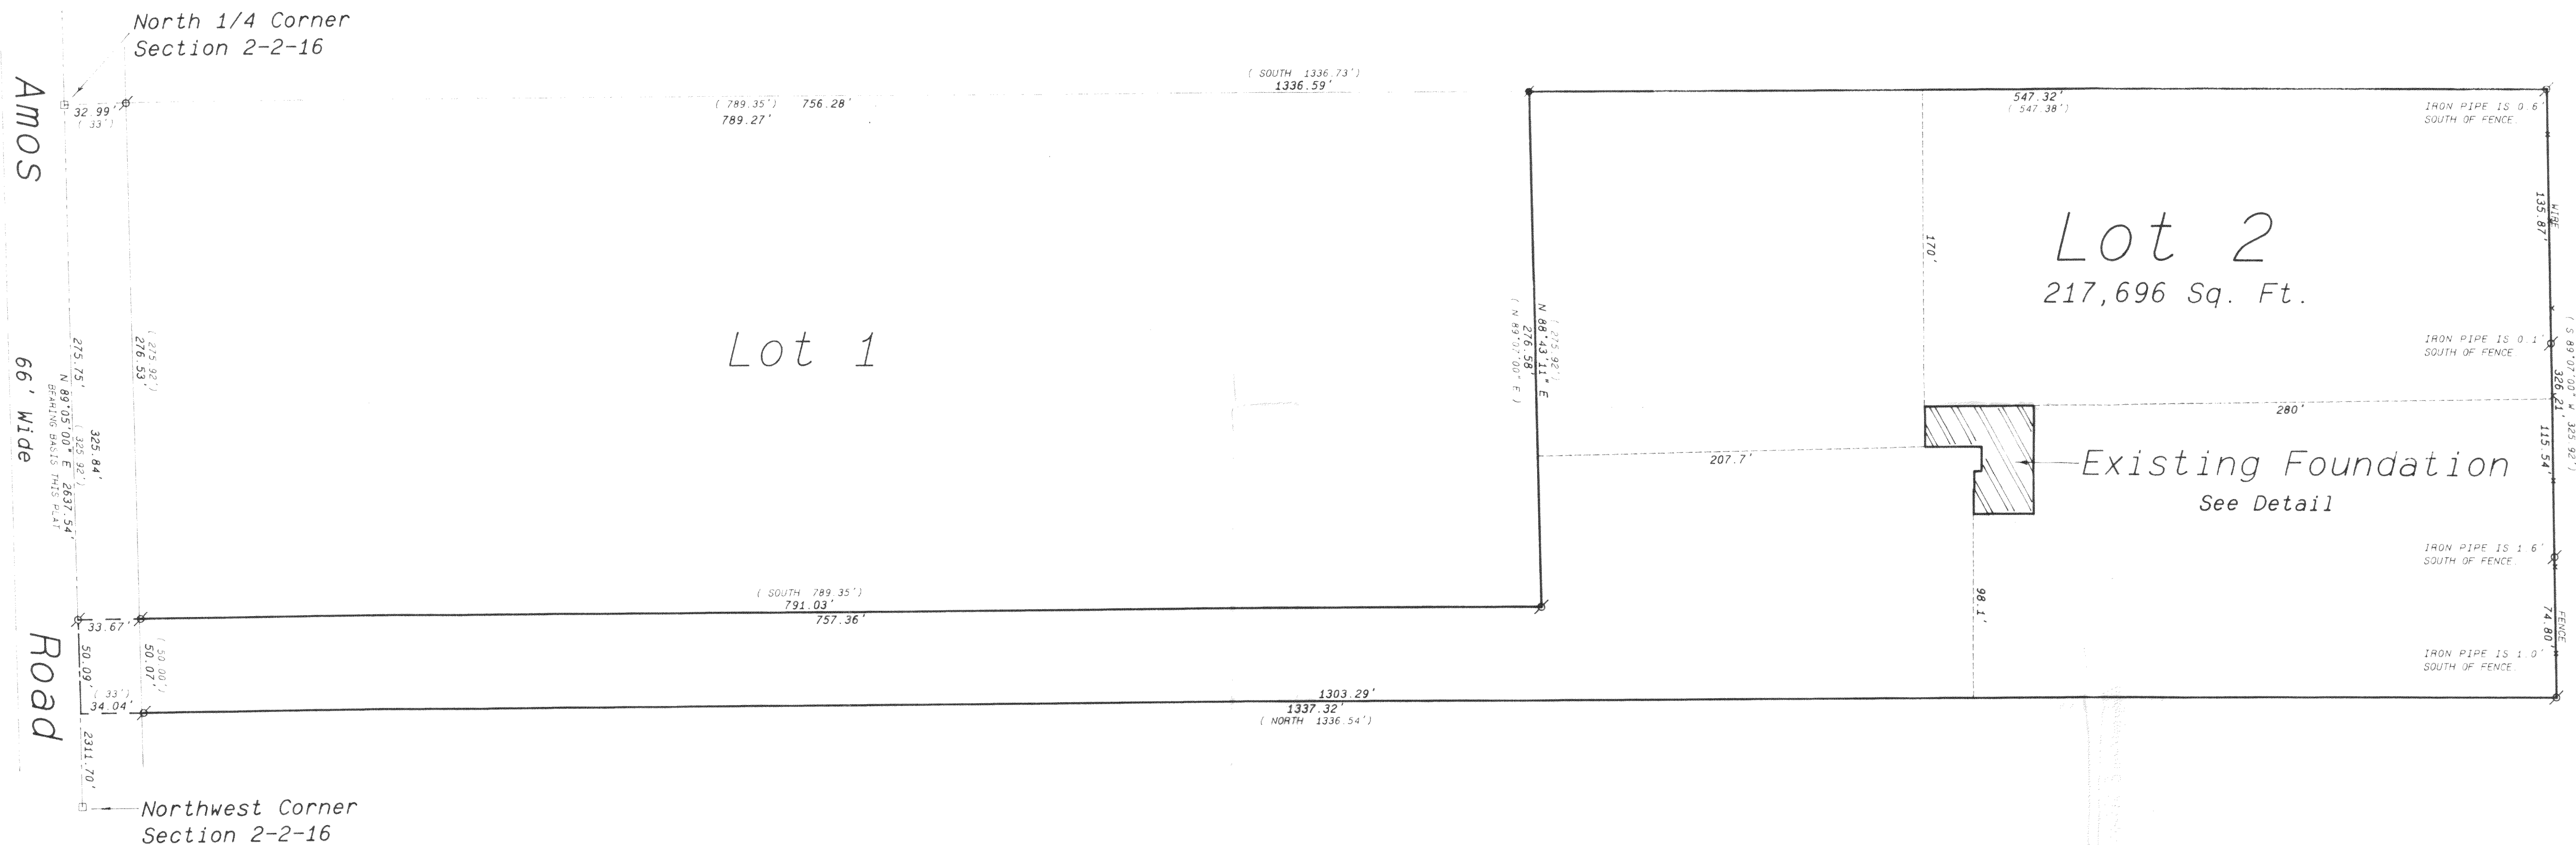

Ordered by: Schauder Building, Inc.
4115 Highway 51 North
Janesville, Wisconsin
53545-9674

Owners: Deanna Zimmerman & Dennis Karbowski

Revised November 11, 2001

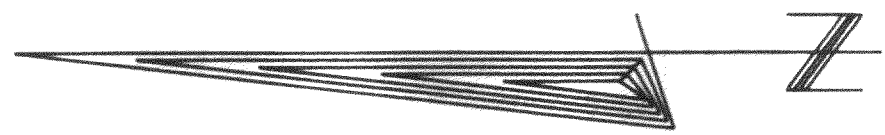

Scale: 1 Inch = 50 Feet

Legend

- FOUND IRON PIPE
- FOUND IRON ROD
- FOUND BRASS CAPPED MONUMENT
- FOUND CONCRETE MONUMENT
- CHISEL CUT IN CONCRETE
- SET IRON ROD 24" LONG, WEIGHING 1.5 LBS. LINEAL FT., 3/4" DIA.
- SET IRON ROD 36" LONG, WEIGHING 4.5 LBS. LINEAL FT., 1 1/16" DIA.
- RECORDED AS DIMENSION
- EXISTING FENCE



SCALE: 1"=50 FEET

I hereby certify that the above described property has been surveyed by me or under my direction and that the above map is a true representation thereof and shows the size and location of the property, its exterior boundaries, the location of all visible structures and dimensions of all principal buildings thereon, boundary fences, apparent easements, roadways and visible encroachments, if any.
This survey is made for the use of the present owners of the property, and also those who purchase, mortgage, or guarantee the title thereto, within one year from date hereof.

Kenneth B. Abernathy, Jr.
KENNETH B. ABERNATHY, JR.
WISCONSIN REGISTERED LAND SURVEYOR,
S-1594
Date: JULY 14, 1997 Job No. 97614

FA-1971-2
216-3165