


**ABELL  
SURVEYING & MAPPING**  
1140 SEQUOIA STREET • DELAVAN, WISCONSIN 53115  
262-728-6737

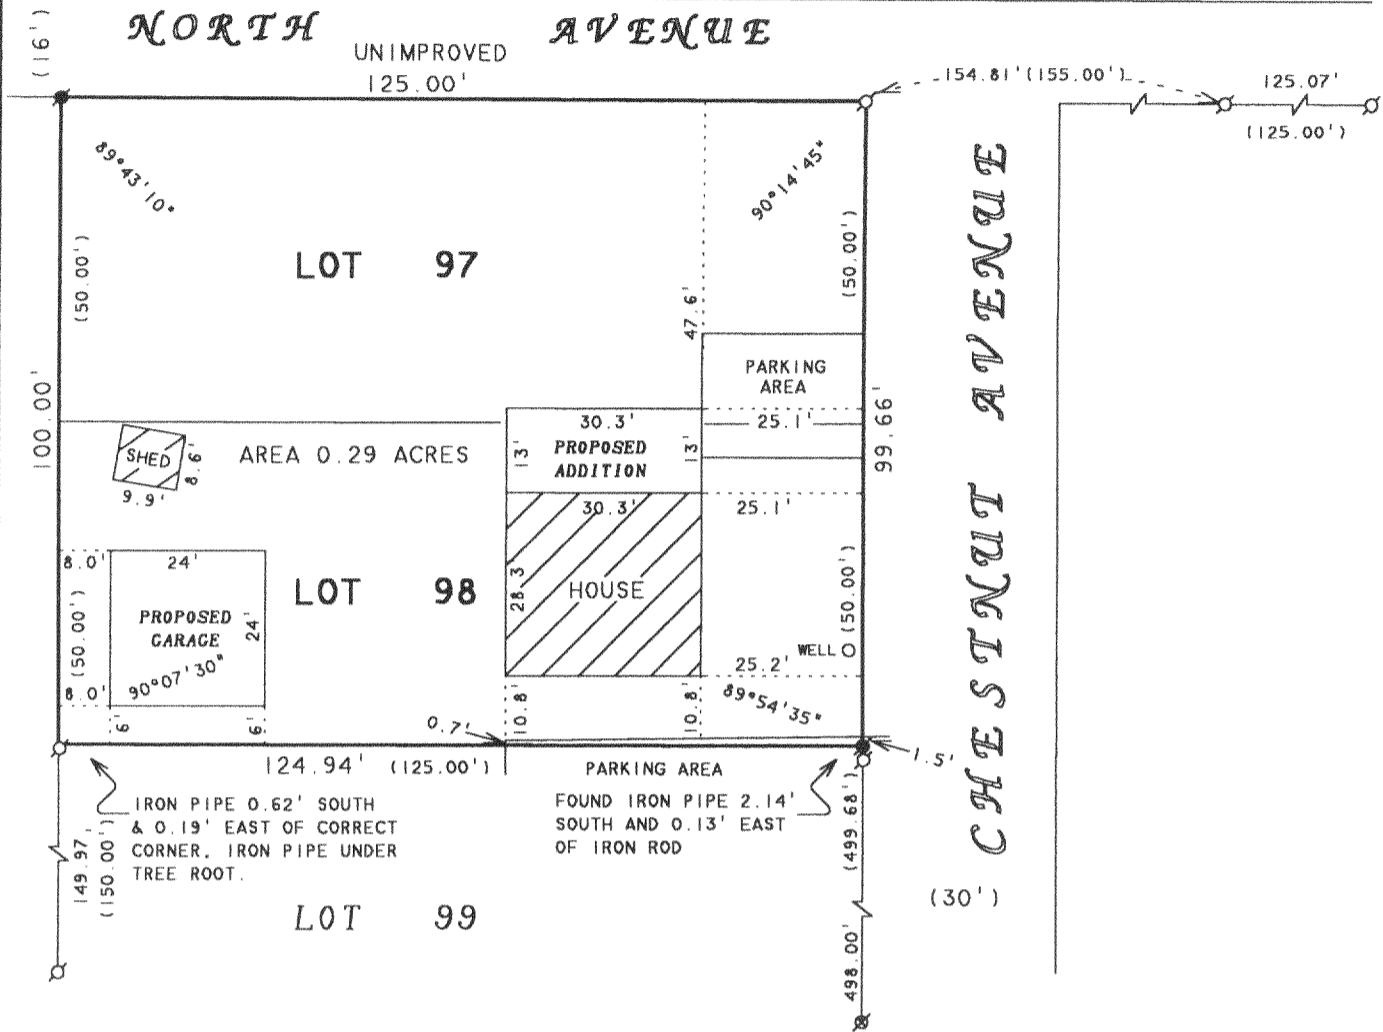

ORDERED BY: CENTURY 21-SKANDIA REALTY  
822 E. GENEVA STREET  
DELAVAN, WI 53115

**PLAT OF SURVEY OF**

LOTS 97 AND 98, LAKE DELAVAN HIGHLANDS, LOCATED  
IN T2N, R16E, WALWORTH COUNTY, WISCONSIN.

NOTE: ABOVE LOTS PREVIOUSLY SURVEYED BY THIS OFFICE ON APR. 4, 1988.



SCALE 1"=30'

**LEGEND**

- ⊙ - IRON PIPE FOUND
- ⊙ - IRON ROD FOUND
- ⊙ - PK NAIL FOUND
- ( ) - RECORDED AS



I HEREBY CERTIFY THAT I HAVE SURVEYED THE ABOVE DESCRIBED PROPERTY AND THAT THE ABOVE MAP IS A TRUE REPRESENTATION THEREOF AND SHOWS THE SIZE AND LOCATION OF THE PROPERTY, ITS EXTERIOR BOUNDARIES, THE LOCATION OF ALL VISIBLE STRUCTURES AND DIMENSIONS OF ALL PRINCIPAL BUILDINGS THEREON, BOUNDARY FENCES, APPARENT EASEMENTS, ROADWAYS AND VISIBLE ENCROACHMENTS, IF ANY, TO THE BEST OF MY KNOWLEDGE AND BELIEF.

THIS SURVEY IS MADE FOR THE USE OF THE PRESENT OWNERS OF THE PROPERTY, AND ALSO THOSE WHO PURCHASE, MORTGAGE, OR GUARANTEE THE TITLE THERETO WITHIN ONE (1) YEAR FROM DATE HEREON.

*David F. Abell*

DAVID F. ABELL  
WISCONSIN REGISTERED LAND SURVEYOR, S-1596

REVISED: APRIL 25, 2002 TO SHOW  
THE PROPOSED GARAGE AND ADDITION

ORDERED BY: JOHN CANGELOS  
1967 N. LOCKWOOD AVE.  
CHICAGO, IL 60639

*January 22, 2002*

DATE: \_\_\_\_\_ JOB NUMBER - 88046B  
NOTE: THIS IS NOT A CERTIFIED COPY UNLESS SEALED.

FLAD-79

216-3172