

ABELL SURVEYING & MAPPING

1140 SEQUOIA STREET • DELAVAN, WISCONSIN 53115
262-728-6737


REVISED DATE: JANUARY 3, 2002
REVISED TO SHOW GARAGE UNDER CONSTRUCTION

REVISED DATE: AUGUST 12, 1999
REVISED TO SHOW HOUSE UNDER CONSTRUCTION

ORDERED BY: ZELL WOODWORKING
1299 CENTER STREET
DELAVAN, WI 53115

ORDERED BY: BRENNAN, STEIL,
BASTING &
MacDOUGALL, S.C.
512 EAST WALWORTH AVENUE
P.O. BOX 446
DELAVAN, WI 53115

NOTE: BEARINGS ARE REFERENCED TO THE
RECORDED SUBDIVISION PLAT.

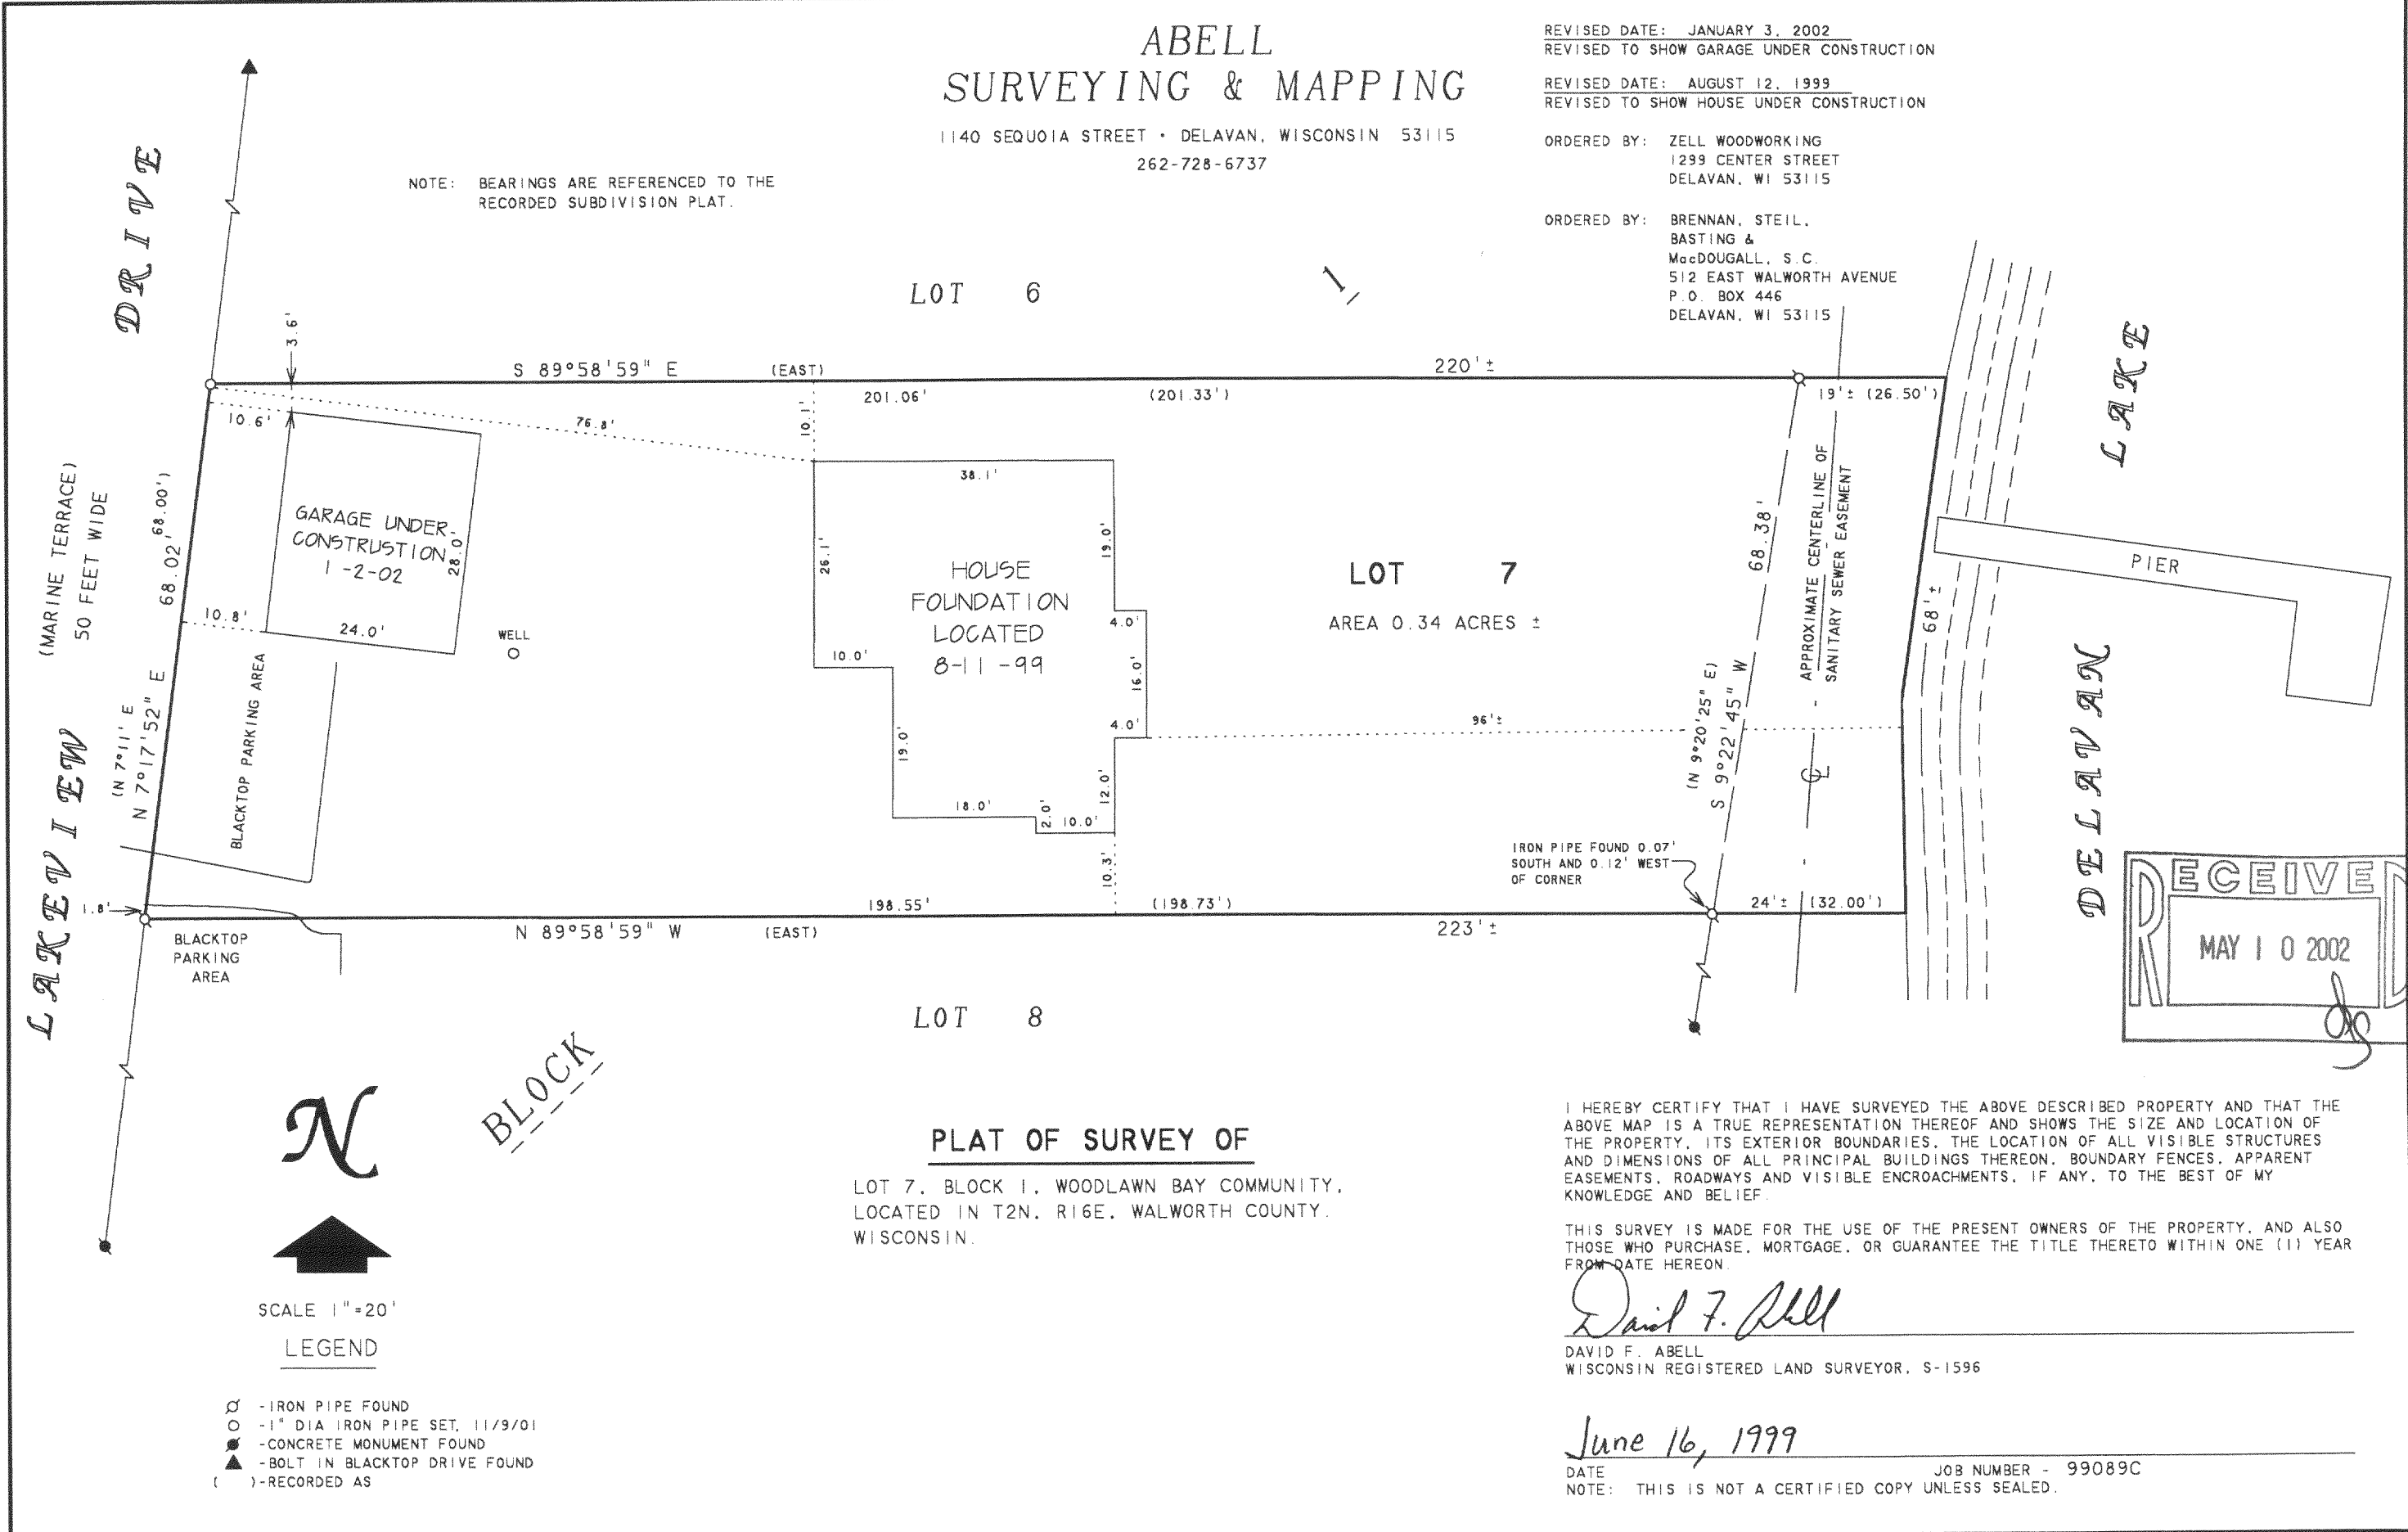

RECEIVED
MAY 10 2002

I HEREBY CERTIFY THAT I HAVE SURVEYED THE ABOVE DESCRIBED PROPERTY AND THAT THE ABOVE MAP IS A TRUE REPRESENTATION THEREOF AND SHOWS THE SIZE AND LOCATION OF THE PROPERTY, ITS EXTERIOR BOUNDARIES, THE LOCATION OF ALL VISIBLE STRUCTURES AND DIMENSIONS OF ALL PRINCIPAL BUILDINGS THEREON, BOUNDARY FENCES, APPARENT EASEMENTS, ROADWAYS AND VISIBLE ENCROACHMENTS, IF ANY, TO THE BEST OF MY KNOWLEDGE AND BELIEF.

THIS SURVEY IS MADE FOR THE USE OF THE PRESENT OWNERS OF THE PROPERTY, AND ALSO THOSE WHO PURCHASE, MORTGAGE, OR GUARANTEE THE TITLE THERETO WITHIN ONE (1) YEAR FROM DATE HEREON.

David F. Abell

DAVID F. ABELL
WISCONSIN REGISTERED LAND SURVEYOR, S-1596

June 16, 1999

DATE: _____ JOB NUMBER - 99089C
NOTE: THIS IS NOT A CERTIFIED COPY UNLESS SEALED.

N
↑
SCALE 1"=20'
LEGEND

- - IRON PIPE FOUND
- - 1" DIA IRON PIPE SET, 11/9/01
- - CONCRETE MONUMENT FOUND
- ▲ - BOLT IN BLACKTOP DRIVE FOUND
- () - RECORDED AS

FWO-7 216-3176