


1140 SEQUOIA STREET • DELAVAN, WISCONSIN 53115  
262-728-6737

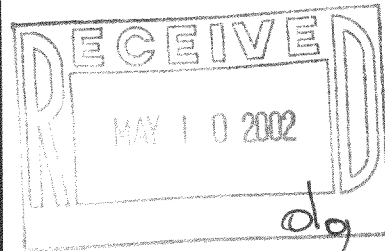

IRON PIPE FOUND 0.04'  
SOUTH AND 0.31' EAST-  
OF CORNER

NOTE: THERE IS NO CURVE DATA ON THE ORIGINAL  
PLAT OF DELAVAN LAKE ASSEMBLY GROUNDS.  
THE EASTERLY LINE OF LOTS 7-9, BLOCK "P"  
WAS SCALED OFF THE ORIGINAL PLAT.

Diagram showing a concrete retaining wall and an iron rod found 1.65' east of the corner. The wall is 0.2' to 0.5' S.E. of the line. The corner is 10.00' from the line. The line is 0.4' ± east of the line.

ORDERED BY: COOK CONSTRUCTION  
2666 COUNTY TRUNK "O" SOUTH  
DELAVER, WI 53115

1. DAVID F. ABELL, DO HEREBY CERTIFY THAT I HAVE SURVEYED THE PROPERTY HEREON  
DESCRIBED ACCORDING TO THE OFFICAL RECORDS AND THAT THE PLAT HEREON IS A  
CORRECT REPRESENTATION OF THE PROPERTY LINES TO THE BEST OF MY KNOWLEDGE AND  
BELIEF.

DAVID F. ABELL  
WISCONSIN REGISTERED LAND SURVEYOR. S-1596

December 11, 2001

DATE \_\_\_\_\_ JOB NUMBER - 01167  
NOTE: THIS IS NOT A CERTIFIED COPY UNLESS SEALED.



SCALE 1" = 10'

### LEGEND

- ⊗ - IRON PIPE FOUND
- ⊗ - IRON ROD FOUND
- - 1" DIA. IRON PIPE SET
- - 7/8" DIA. IRON ROD
- SET IN BLACKTOP ROADWAY
- - OVERHEAD UTILITY LINES
- ( ) - RECORDED AS

## PLAT OF SURVEY OF

LOT 8, THE NORTH 10 FEET OF LOT 7  
AND THE SOUTH 12 FEET OF LOT 9.  
BLOCK "P", DELAVAN LAKE ASSEMBLY  
GROUNDS, LOCATED IN T2N, R16E,  
WALWORTH COUNTY, WISCONSIN.

THE HEIGHT OF THE RESIDENCE FROM GRADE TO PEAK  
AT FRONT OF HOUSE IS 26.1'.

FIRST FLOOR ELEVATION AT FRONT DOOR IS 100.1'.