

ABELL SURVEYING & MAPPING

1140 SEQUOIA STREET . DELAVAN, WISCONSIN 53115 262-728-6737

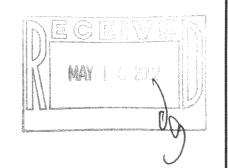

RAVENSWOOD DRIVE

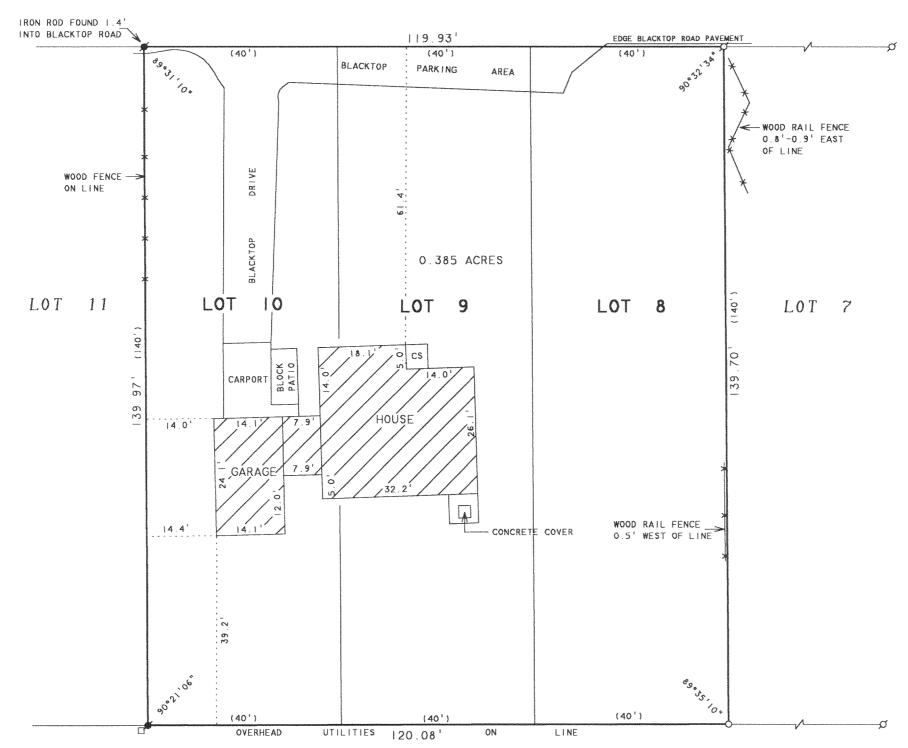

PLAT OF SURVEY OF

LOTS 8-10 OF KRUMHAAR'S ADDITION TO RAVENSWOOD. LOCATED IN T2N, R16E, WALWORTH COUNTY, WISCONSIN

ORDERED BY: KILKENNY LAW OFFICE 125 N. 2nd STREET DELAVAN, WI 53115





SCALE | " = 20"

LEGEND

₩ - IRON ROD FOUND Ø - IRON PIPE FOUND O - I" DIA. IRON PIPE SET

CP - CONCRETE STOOP

☐ - UTILITY PED () - RECORDED AS

I HEREBY CERTIFY THAT I HAVE SURVEYED THE ABOVE DESCRIBED PROPERTY AND THAT THE ABOVE MAP IS A TRUE REPRESENTATION THEREOF AND SHOWS THE SIZE AND LOCATION OF THE PROPERTY, ITS EXTERIOR BOUNDARIES, THE LOCATION OF ALL VISIBLE STRUCTURES AND DIMENSIONS OF ALL PRINCIPAL BUILDINGS THEREON, BOUNDARY FENCES, APPARENT EASEMENTS, ROADWAYS AND VISIBLE ENCROACHMENTS, IF ANY, TO THE BEST OF MY KNOWLEDGE AND BELIEF

THIS SURVEY IS MADE FOR THE USE OF THE PRESENT OWNERS OF THE PROPERTY, AND ALSO THOSE WHO PURCHASE, MORTGAGE, OR GUARANTEE THE TITLE THERETO WITHIN ONE (I) YEAR FROM DATE HEREON.

DAVID F. ABELL WISCONSIN REGISTERED LAND SURVEYOR, S-1596

February 25, 2002

DATE JOB NUMBER - 02021 NOTE: THIS IS NOT A CERTIFIED COPY UNLESS SEALED.