



Tax Key No. FWIA 00007

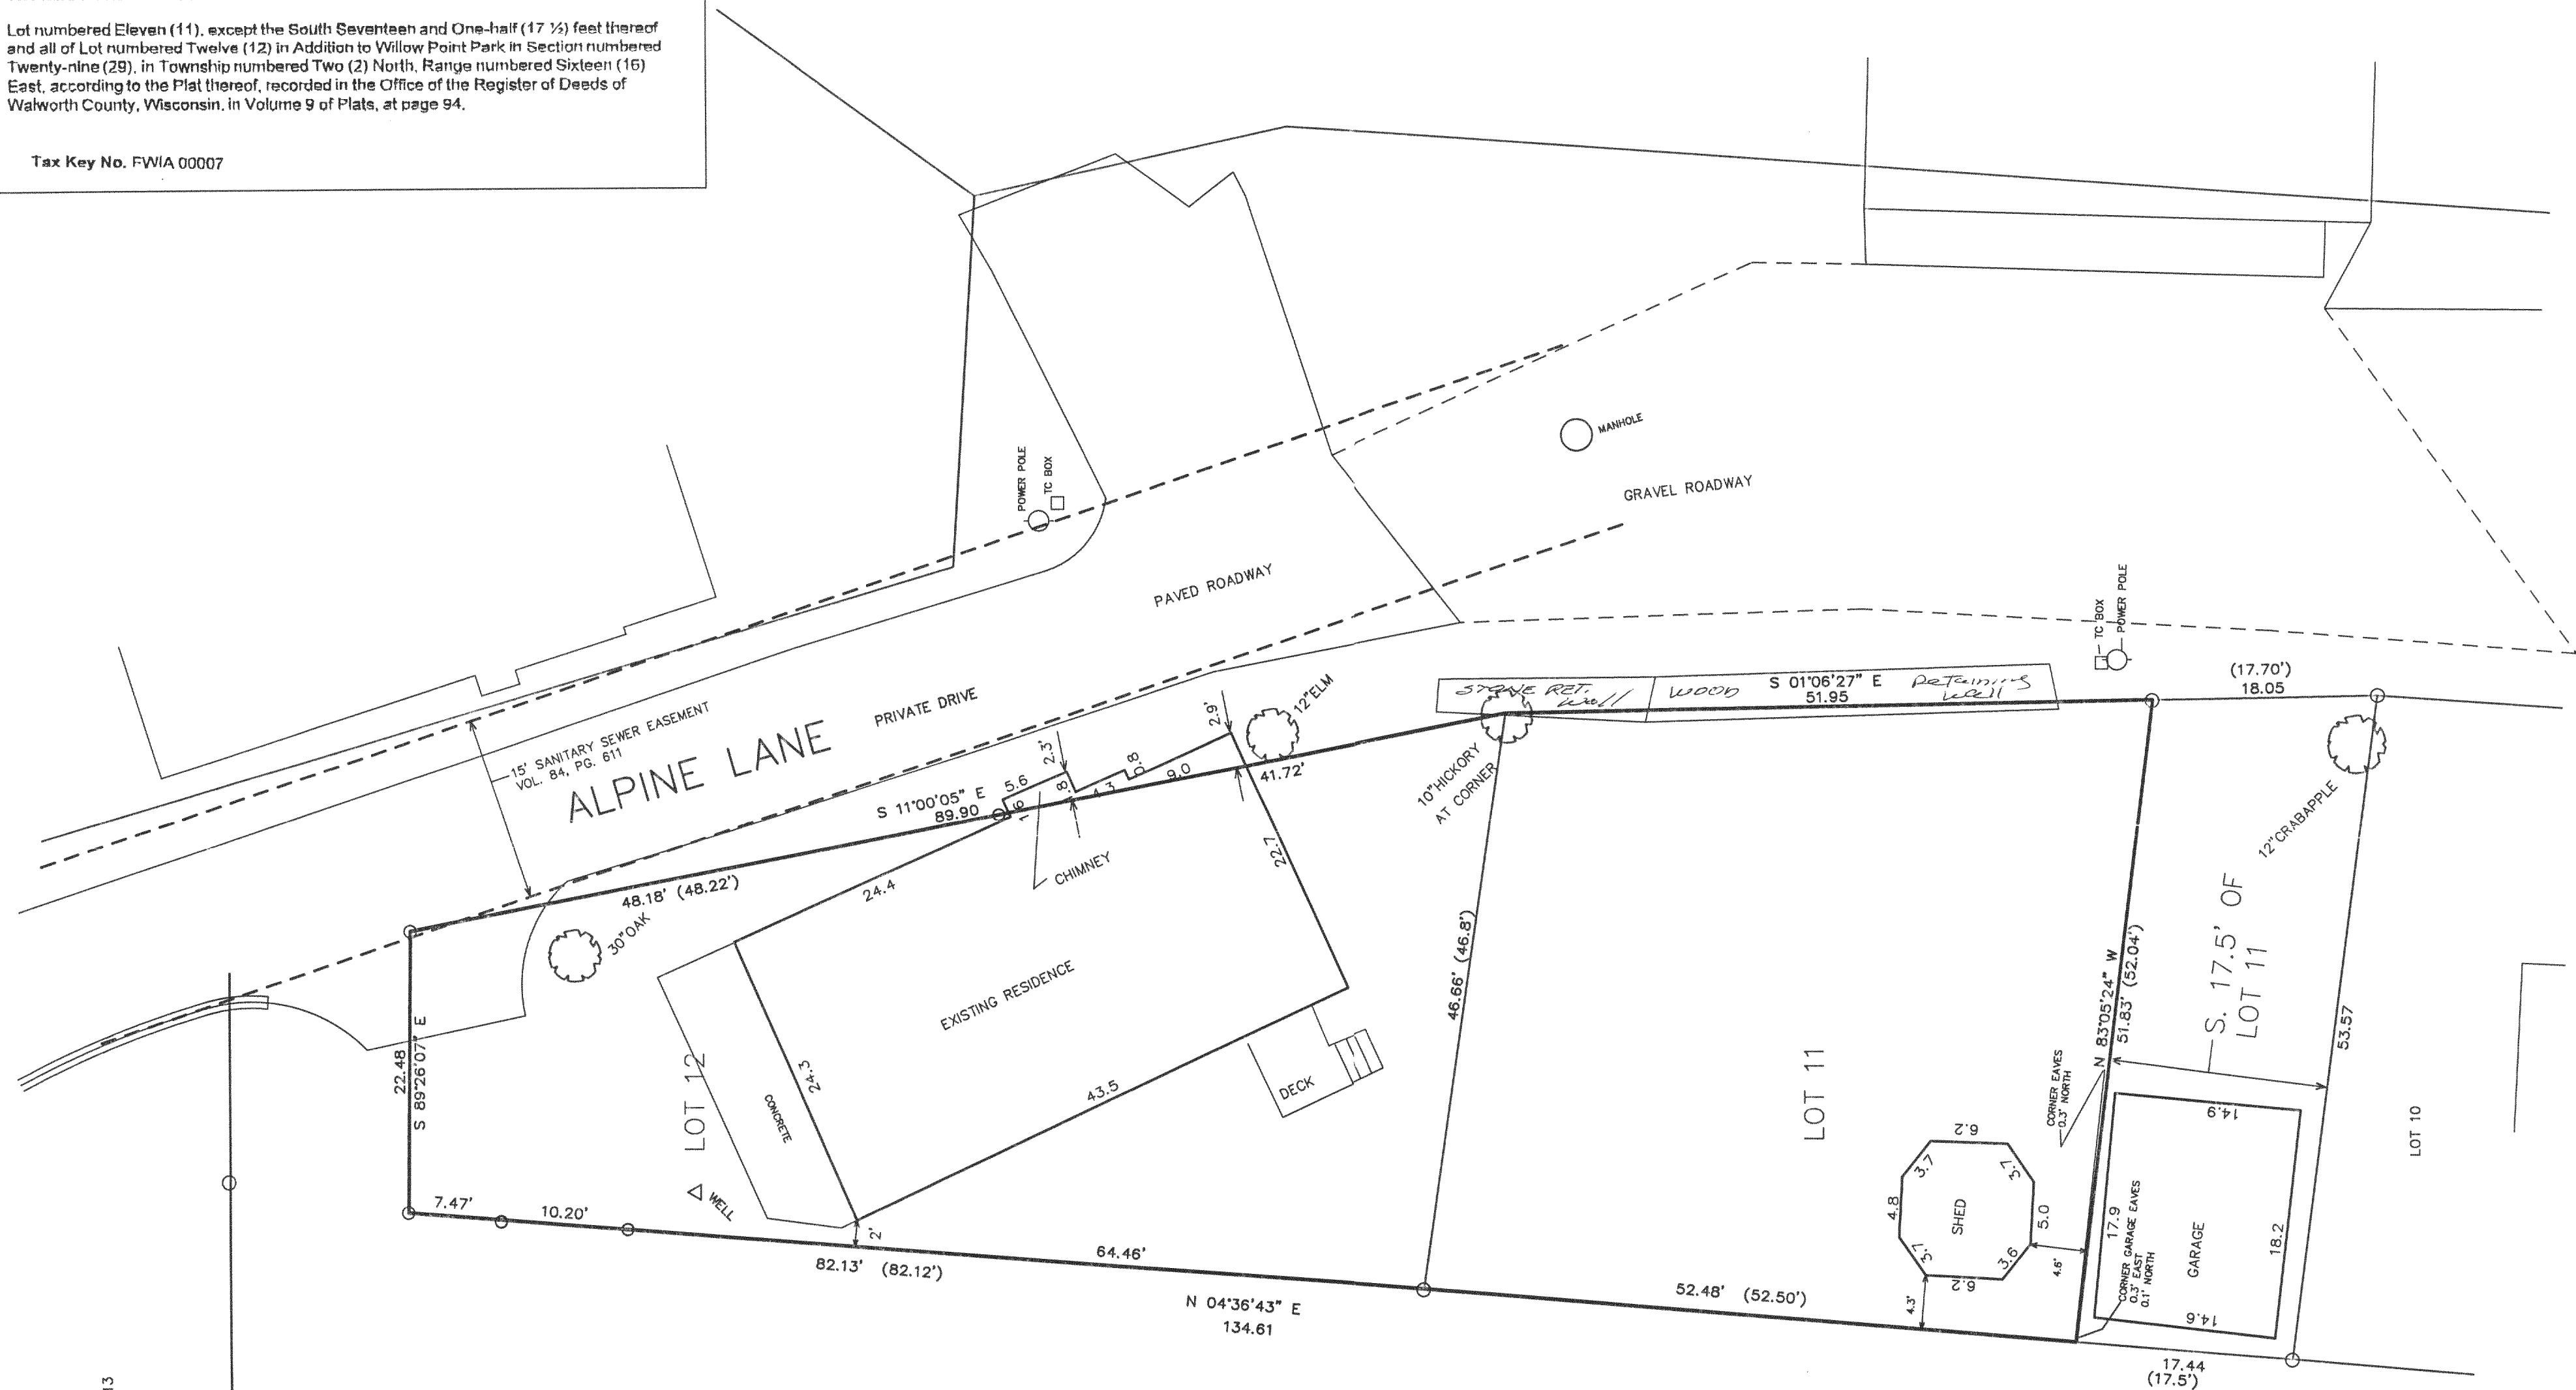


LOT 13

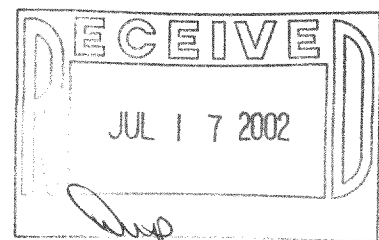

ASSIGNED WEST LINE LOT 12  
N 04°36'43" E

○ = FOUND IRON PIPE STAKE  
(xxx) = RECORDED AS SHOWN ON  
PLAT OF SURVEY BY LLOYD JENSEN  
COUNTY SURVEYOR DATED AUG. 1944

AREA = 5460 S.F

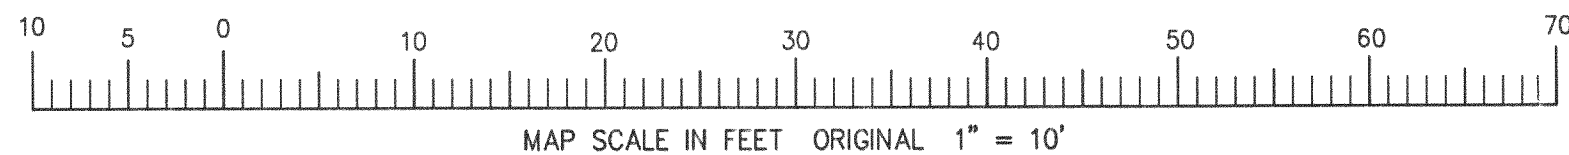

DATED: JUNE 25, 2002

PETER S. GORDON R.L.S. 2101

**FARRIS, HANSEN & ASSOCIATES, INC.**  
ENGINEERING — ARCHITECTURE — SURVEYING  
7 RIDGWAY COURT P.O. BOX 437  
ELKHORN, WISCONSIN 53121  
OFFICE: (262) 723-2098 FAX: (262) 723-5886

## REVISIONS

PROJECT NO.
6054
DATE:
06-25-02
SHEET NO.
1 OF 1