
06/14/2002-ASBUILT INFO.


PROJECT NO. 5398.02

DATE: 02-21-02 SHEET NO. 1 OF 1

PLAT OF SURVEY LOT 2 CSM 3216

LOCATED IN THE NW 1/4 OF THE NE 1/4 OF SECTION 15, TOWN 2 NORTH, RANGE 16 EAST, WALWORTH COUNTY, WI

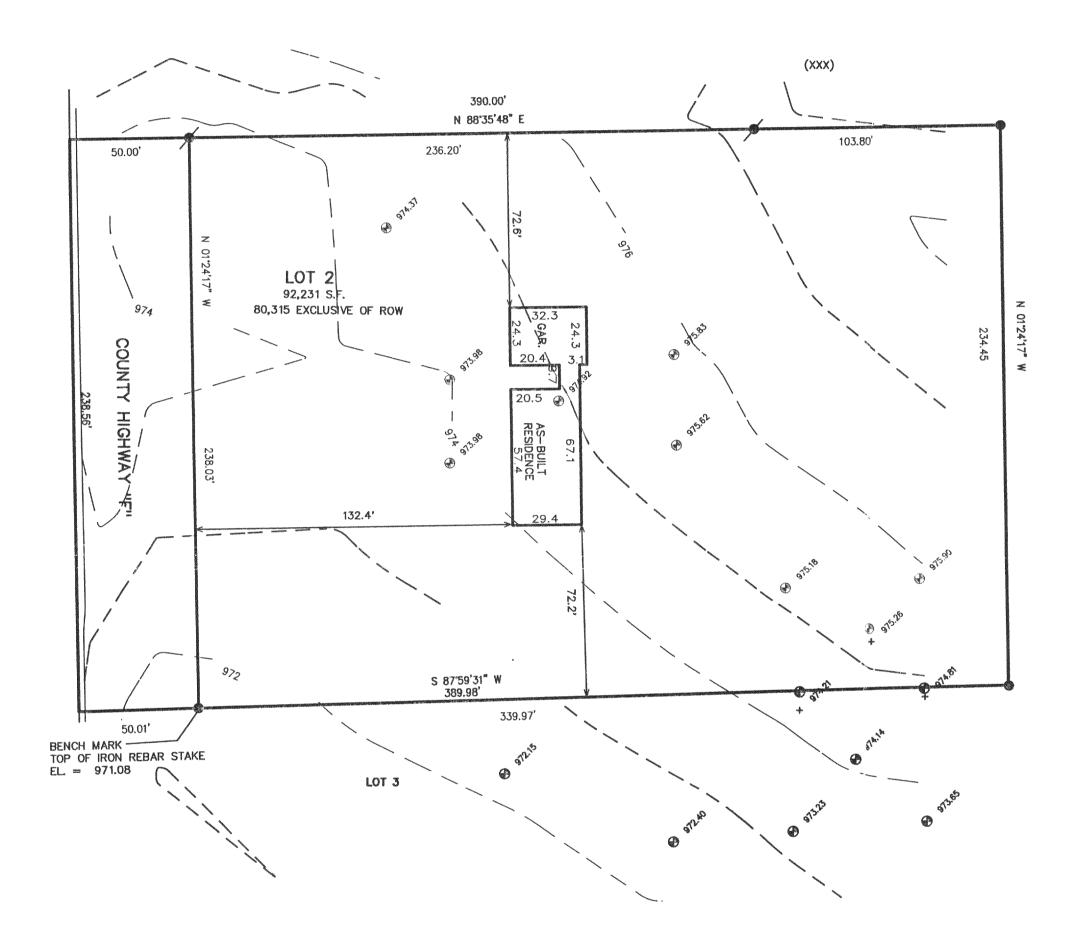

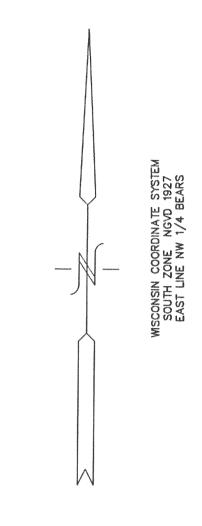

LEGEND

FOUND IRON REBAR STAKE
SOIL BORING
RECORDED AS

NOTE: COPIES OF THIS MAP TO WHICH THE FOLLOWING CERTIFICATE WILL APPLY SHOW THE SURVEYOR'S ORIGINAL SEAL AND SIGNATURE IN RED INK. COPIES BY ANY OTHER MEANS MAY HAVE ALTERATIONS WHICH DO NOT REPRESENT THE SURVEYOR'S WORK PRODUCT.

I HEREBY CERTIFY THAT THE ABOVE DESCRIBED PROPERTY HAS BEEN SURVEYED UNDER MY DIRECTION AND THAT THE ABOVE MAP IS A TRUE REPRESENTATION THEREOF AND SHOWS THE SIZE AND LOCATION OF THE PROPERTY AND ITS EXTERIOR BOUNDARIES. THIS SURVEY IS MADE FOR THE USE OF THE PRESENT OWNERS OF THE PROPERTY, AND ALSO THOSE WHO PURCHASE, MORTGAGE, OR GUARANTEE THE TITLE THERETO WITHIN ONE YEAR FROM THE DATE Revised 6-17-02 to Filew AfBixet 120GIBERCE GIZET VOCATION

90 80 70 60 ⁵⁰ 40 30 20 10 MAP SCALE IN FEET ORIGINAL 1" = 40'

JUN 17 2002

