
PREPARED FOR: C-21 SKANDIA ATTN. RENAE *822 E GENEVA* DELAVAN, WI, 53115

PLAT OF SURVEY

I.K. SURVEYING INC. N3705 WILLOWBEND LANE LAKE GENEVA, WI, 53147 262-248-3697

LOT 3 BLOCK 2, IN SOUTH SHORE MANOR, BEING A SUBDIVISION IN SECTION 32, TOWN 2 NORTH, RANGE 16 EAST, WALWORHT COUNTY,

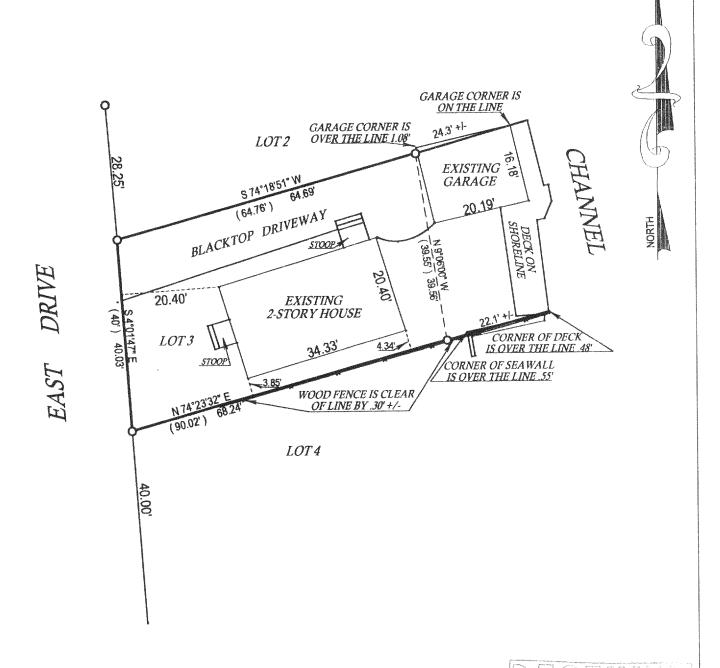

)= recorded as

= found iron bar

= found iron pipe

= set iron pipe

= set iron bar

JOB# 02-242

SCALE: 1"=20"

TAX KEY # FSS-30

COMPARE LEGAL DESCRIPTION ABOVE AND DRAWING WITH DEED. FOR BUILDING RESTRICTIONS AND EASEMENTS NOT SHOWN, REFER TO DEED, ABSTRACT SOURCES AND LOCAL MUNICIPAL CODES. NOTIFY THE SURVEYOR IMMEDIATELY OF ANY DISCREPANCY.

"I hereby certify that I have surveyed the above described property and that the above map is a true representation thereof and shows the size and location of all visible structures, apparent easements and encroachments WIS. OSURVE INTERNATIONAL STREET

This survey is made for the present owners of the property, and those who purchase, mortgage, or guarantee the title thereto, within one year from

the date hereof.

20_02 DATED THIS 03 TH DAY OF JUNE

JOHN KROTT S - 2258 Wisconsin Registered Land Surveyor (original if signed in red)

AUG 1 6 2002

CCOVO! "SCONS"

KROTT

S-2258

MUKWONAGO.