


GEORGE T. DUNHAM
SURVEYING & SUBDIVIDING
DELAVAN, WISCONSIN



N

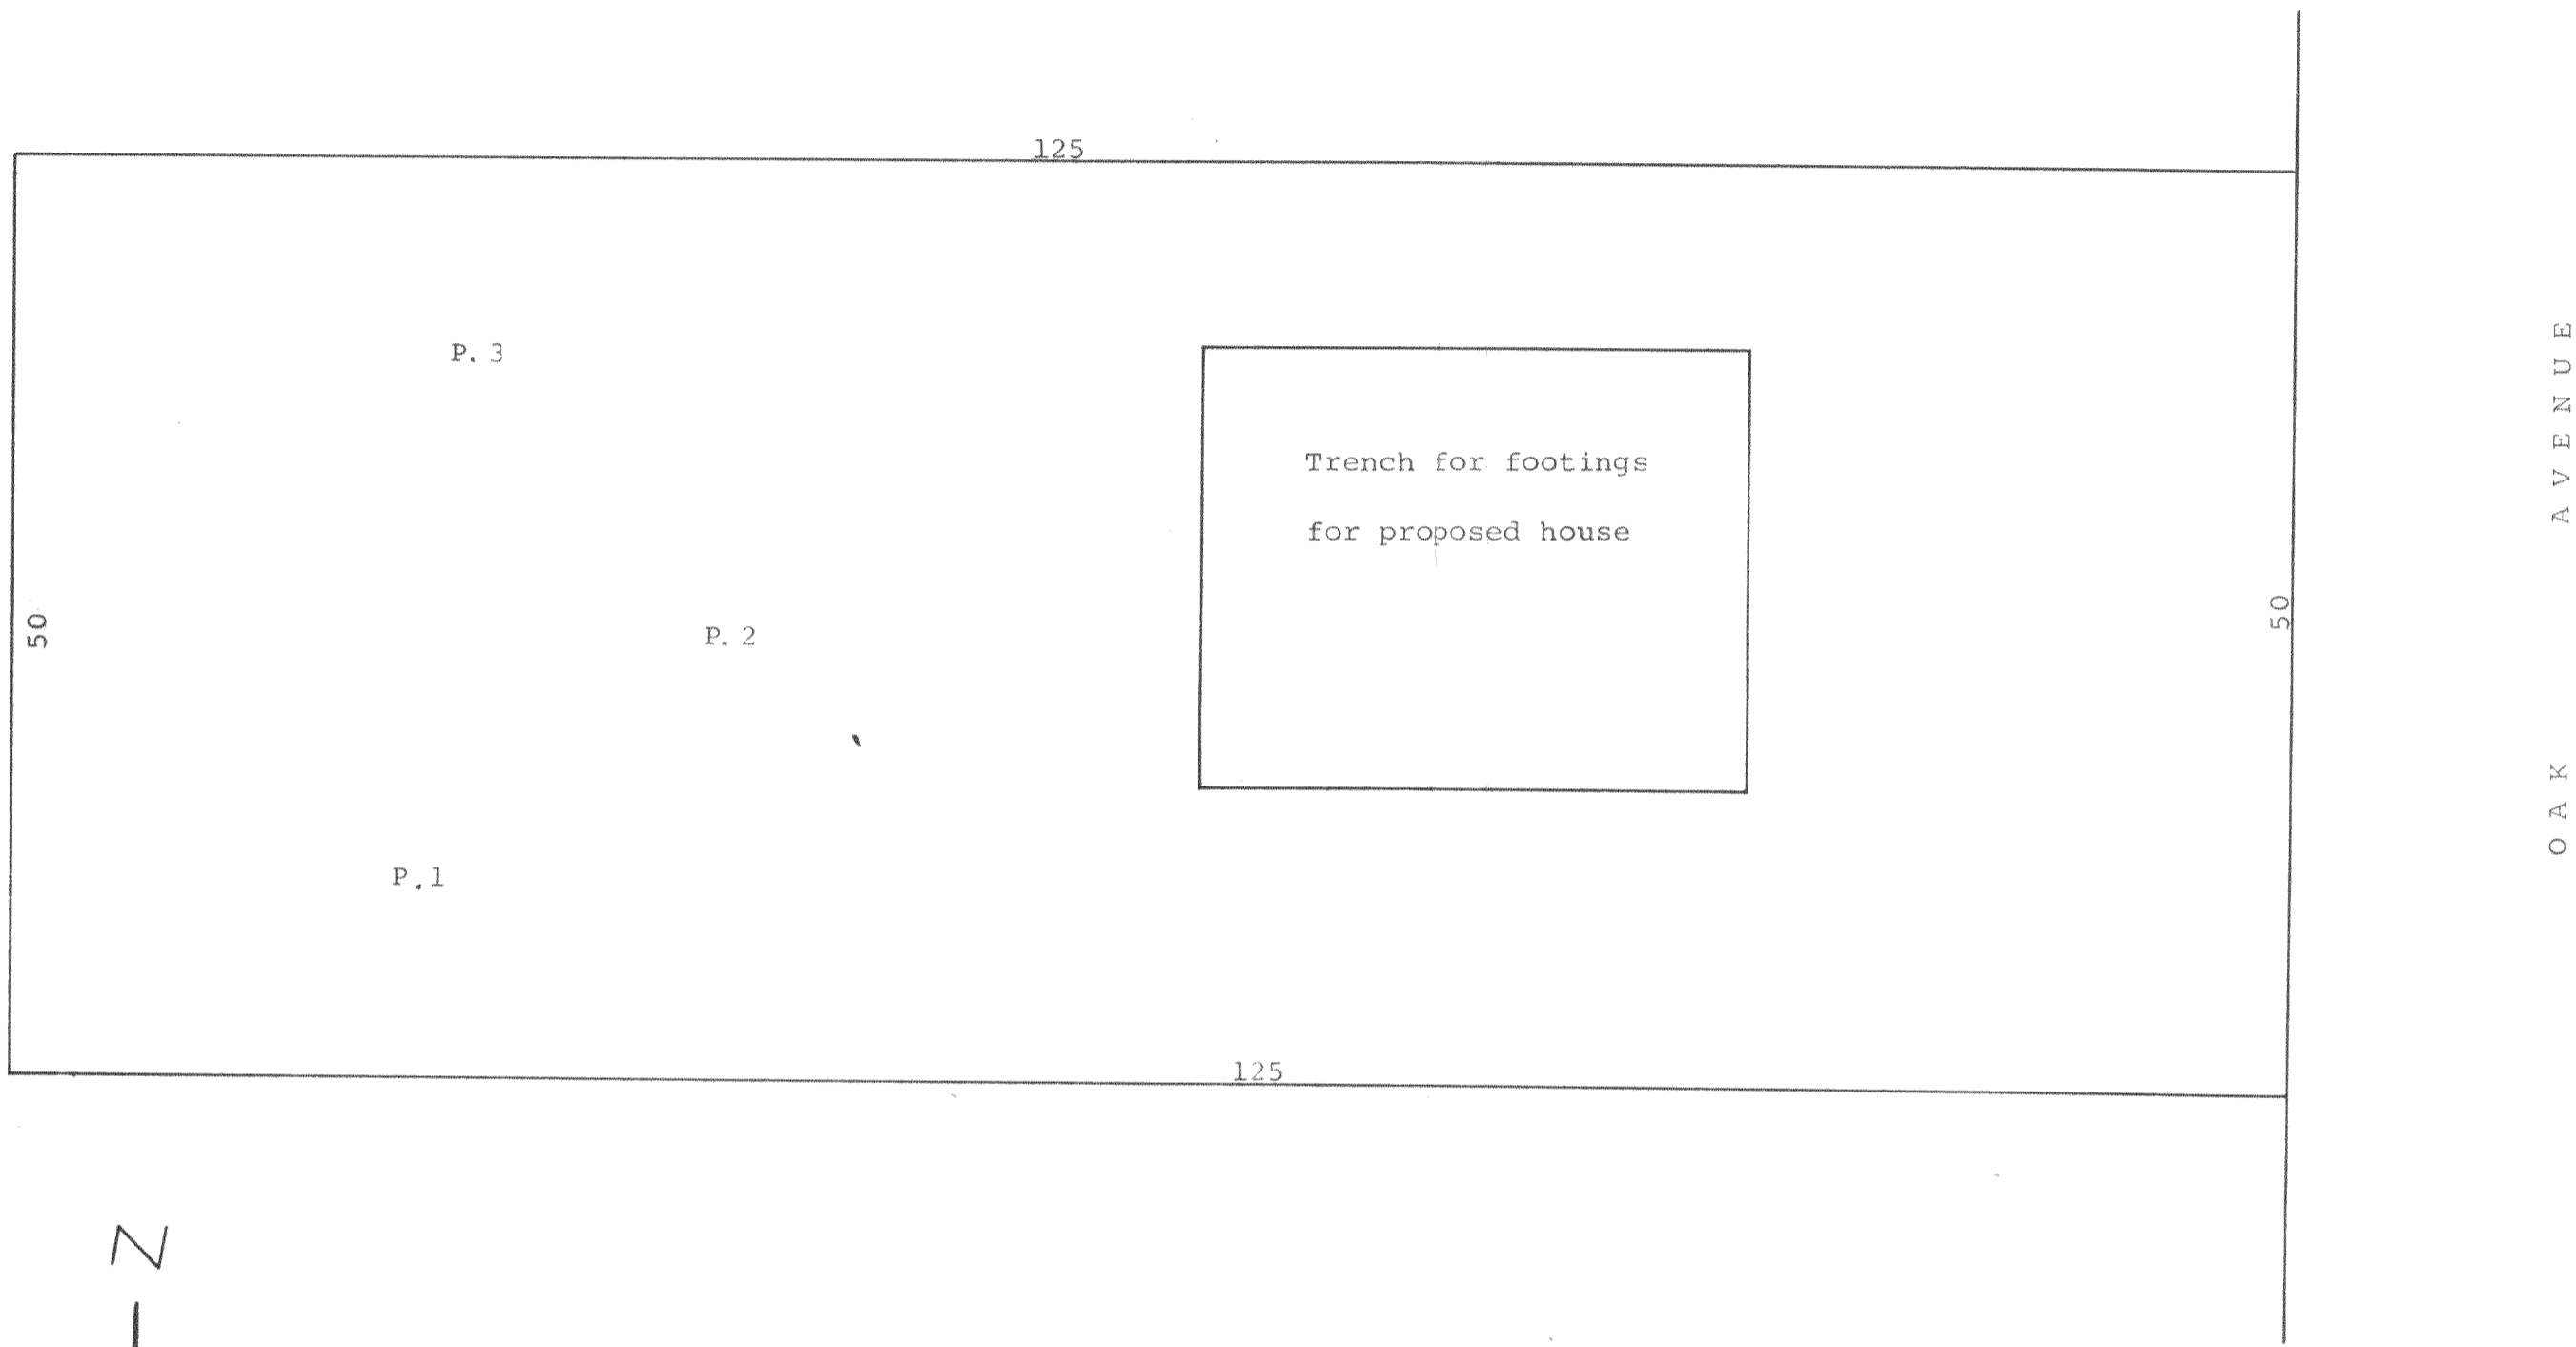

Scale - 1" = 10'

(perc. to ST.)

Plat showing the location of the percolation tests on
Lot 304 in Lake Delavan Highlands, Section 31, T 2 N,
R 16 E, Walworth County, Wisconsin.
July 7, 1967

FLAD-230

George T. Dunham
George T. Dunham, Surveyor

216-323