

ABELL
SURVEYING & MAPPING

1140 SEQUOIA STREET • DELAVAN, WISCONSIN 53115
262-728-6737

LOT 129

AS SURVEYED BY LLOYD L. JENSEN
DATED MAY 8, 1948

S 89°57'44" E 119.84' (120')

LOT 128

LOT 127

LOT 126

I HEREBY CERTIFY THAT I HAVE SURVEYED THE ABOVE DESCRIBED PROPERTY AND THAT THE ABOVE MAP IS A TRUE REPRESENTATION THEREOF AND SHOWS THE SIZE AND LOCATION OF THE PROPERTY, ITS EXTERIOR BOUNDARIES, THE LOCATION OF ALL VISIBLE STRUCTURES AND DIMENSIONS OF ALL PRINCIPAL BUILDINGS THEREON, BOUNDARY FENCES, APPARENT EASEMENTS, ROADWAYS AND VISIBLE ENCROACHMENTS, IF ANY, TO THE BEST OF MY KNOWLEDGE AND BELIEF.

THIS SURVEY IS MADE FOR THE USE OF THE PRESENT OWNERS OF THE PROPERTY, AND ALSO THOSE WHO PURCHASE, MORTGAGE, OR GUARANTEE THE TITLE THERETO WITHIN ONE (1) YEAR FROM DATE HEREON.

David F. Abell

DAVID F. ABELL
WISCONSIN REGISTERED LAND SURVEYOR, S-1596

June 20, 2002

DATE: June 20, 2002 JOB NUMBER - 02080
NOTE: THIS IS NOT A CERTIFIED COPY UNLESS SEALED.

PLAT OF SURVEY OF

LOTS 126-128, KRUMHAAR'S 2nd ADDITION TO
RAVENSWOOD, LOCATED IN T2N, R16E, WALWORTH
COUNTY, WISCONSIN.

AREA 0.33 ACRES

END OF FENCE 0.9'
WEST OF LINE

IRON PIPE FOUND
0.73' WEST OF LINE

END OF FENCE 3.4'
WEST OF LINE

IRON PIPE FOUND 0.21' NORTH
AND 2.54' WEST OF CORNER

FOREST DRIVE

20'

DRIVE

MASCHE

20.00'

20.00'

COUNTRY LANE DRIVE

LOT 120

LOT 121

LOT 122

NOTE: BEARINGS ARE REFERENCED TO
EXISTING SURVEY RECORDS.


N



SCALE 1"=30'

LEGEND

- - IRON PIPE FOUND
- - IRON ROD FOUND
- ⋈ - IRON "T" POST FOUND
- - 1" DIA. IRON PIPE SET
- ⊗ - PK NAIL SET
- X— - WOOD FENCE
- () - RECORDED AS

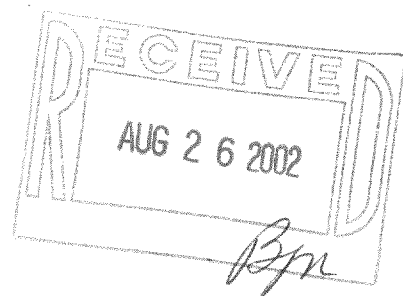

ORDERED BY: HOMESTEAD LAKES REALTY
520 BROAD STREET
LAKE GENEVA, WI 53147

FRA 2-22

216-3234