


1140 SEQUOIA STREET • DELAVAN, WISCONSIN 53115
262-728-6737

1140 SEQUOIA STREET • DELAVAN, WISCONSIN 53115
262-728-6737

A rectangular stamp with the word 'RECEIVED' in large, bold, capital letters at the top. Below it, the date 'AUG 26 2002' is stamped. At the bottom of the stamp, there is a handwritten signature that appears to be 'Bjm'. The stamp is tilted slightly to the right.

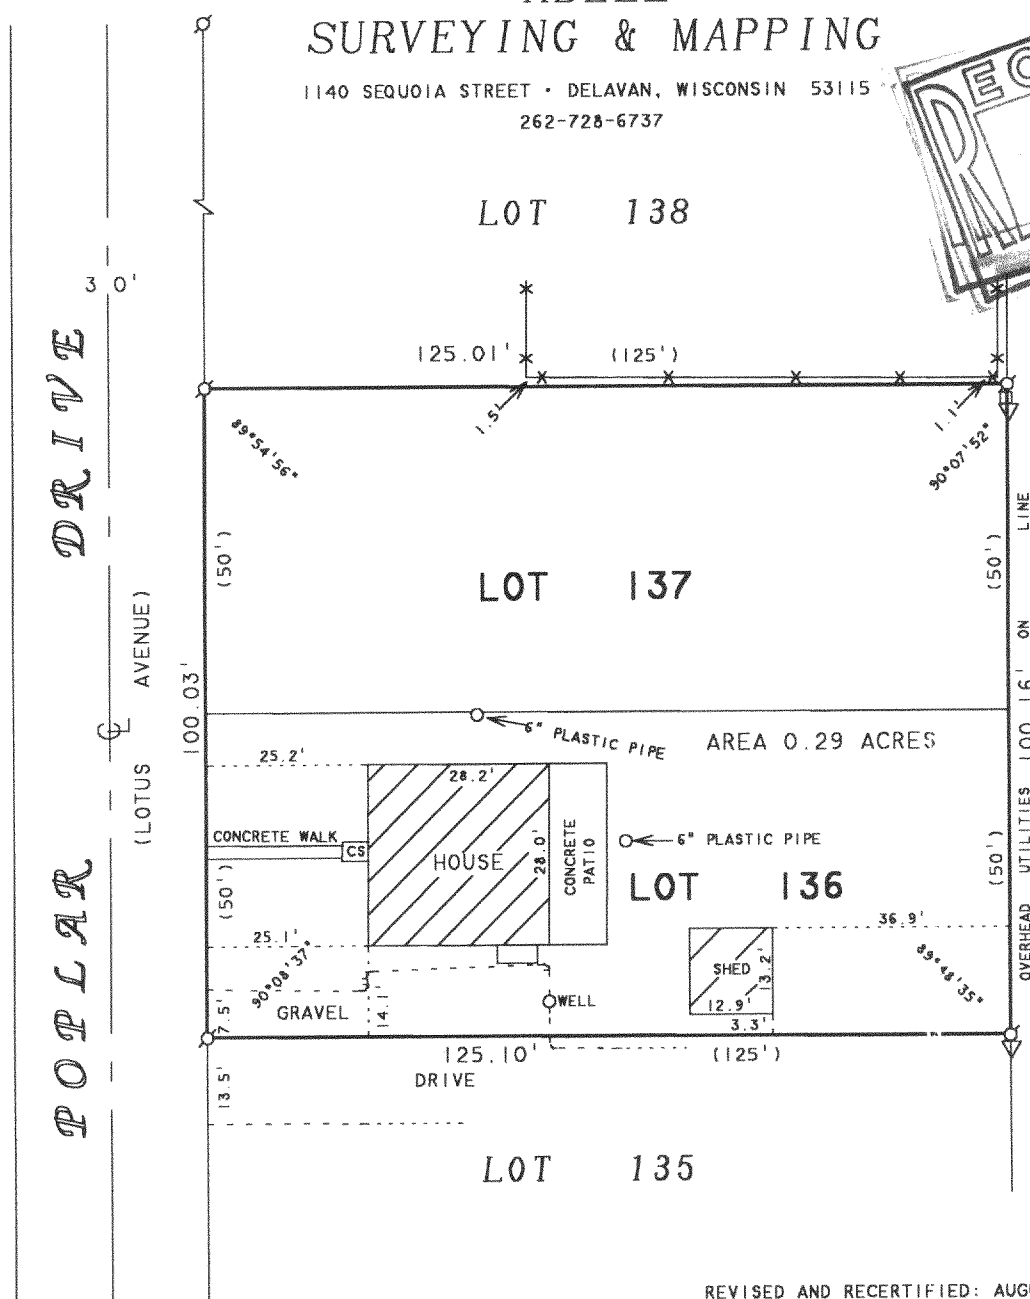

REVISÉD AND RECERTIFIED: AUGUST 1, 2002

ORDERED BY: CENTURY 21-SKANDIA REALTY
822 E. GENEVA STREET
DELAWARE, WI 53115

ORDERED BY: RE/MAX GENEVA REALTY, LTD.
101 BROAD STREET
LAKE GENEVA, WI 53147

LOTS 136 AND 137, LAKE DELAVAN HIGHLANDS.
LOCATED IN T2N, R16E, WALWORTH COUNTY.
WISCONSIN.



SCALE 1" = 30'

Ø - IRON PIPE FOUND
 Δ - UTILITY POLE
 □ - UTILITY PED.
 CS - CONCRETE STOOP
 X-----X - CHAINLINK FENCE
 () - RECORDED AS

I HEREBY CERTIFY THAT I HAVE SURVEYED THE ABOVE DESCRIBED PROPERTY AND THAT THE ABOVE MAP IS A TRUE REPRESENTATION THEREOF AND SHOWS THE SIZE AND LOCATION OF THE PROPERTY, ITS EXTERIOR BOUNDARIES, THE LOCATION OF ALL VISIBLE STRUCTURES AND DIMENSIONS OF ALL PRINCIPAL BUILDINGS THEREON, BOUNDARY FENCES, APPARENT EASEMENTS, ROADWAYS AND VISIBLE ENCROACHMENTS, IF ANY, TO THE BEST OF MY KNOWLEDGE AND BELIEF.

THIS SURVEY IS MADE FOR THE USE OF THE PRESENT OWNERS OF THE PROPERTY, AND ALSO THOSE WHO PURCHASE, MORTGAGE, OR GUARANTEE THE TITLE THERETO WITHIN ONE (1) YEAR FROM DATE HEREON.

FROM DATE HEREON.

DAVID F. ABELL
WISCONSIN REGISTERED LAND SURVEYOR, S-1596

May 2, 1994

DATE _____ JOB NUMBER - 94061A
NOTE: THIS IS NOT A CERTIFIED COPY UNLESS SEALED.

216-3248

FLAD III