


ABELL SURVEYING & MAPPING


1140 SEQUOIA STREET • DELAVAN, WISCONSIN 53115
262-728-6737

CORNER FALLS IN CONCRETE PIT,
FOUND IRON PIPES SET ON 3 FOOT
OFFSETS.

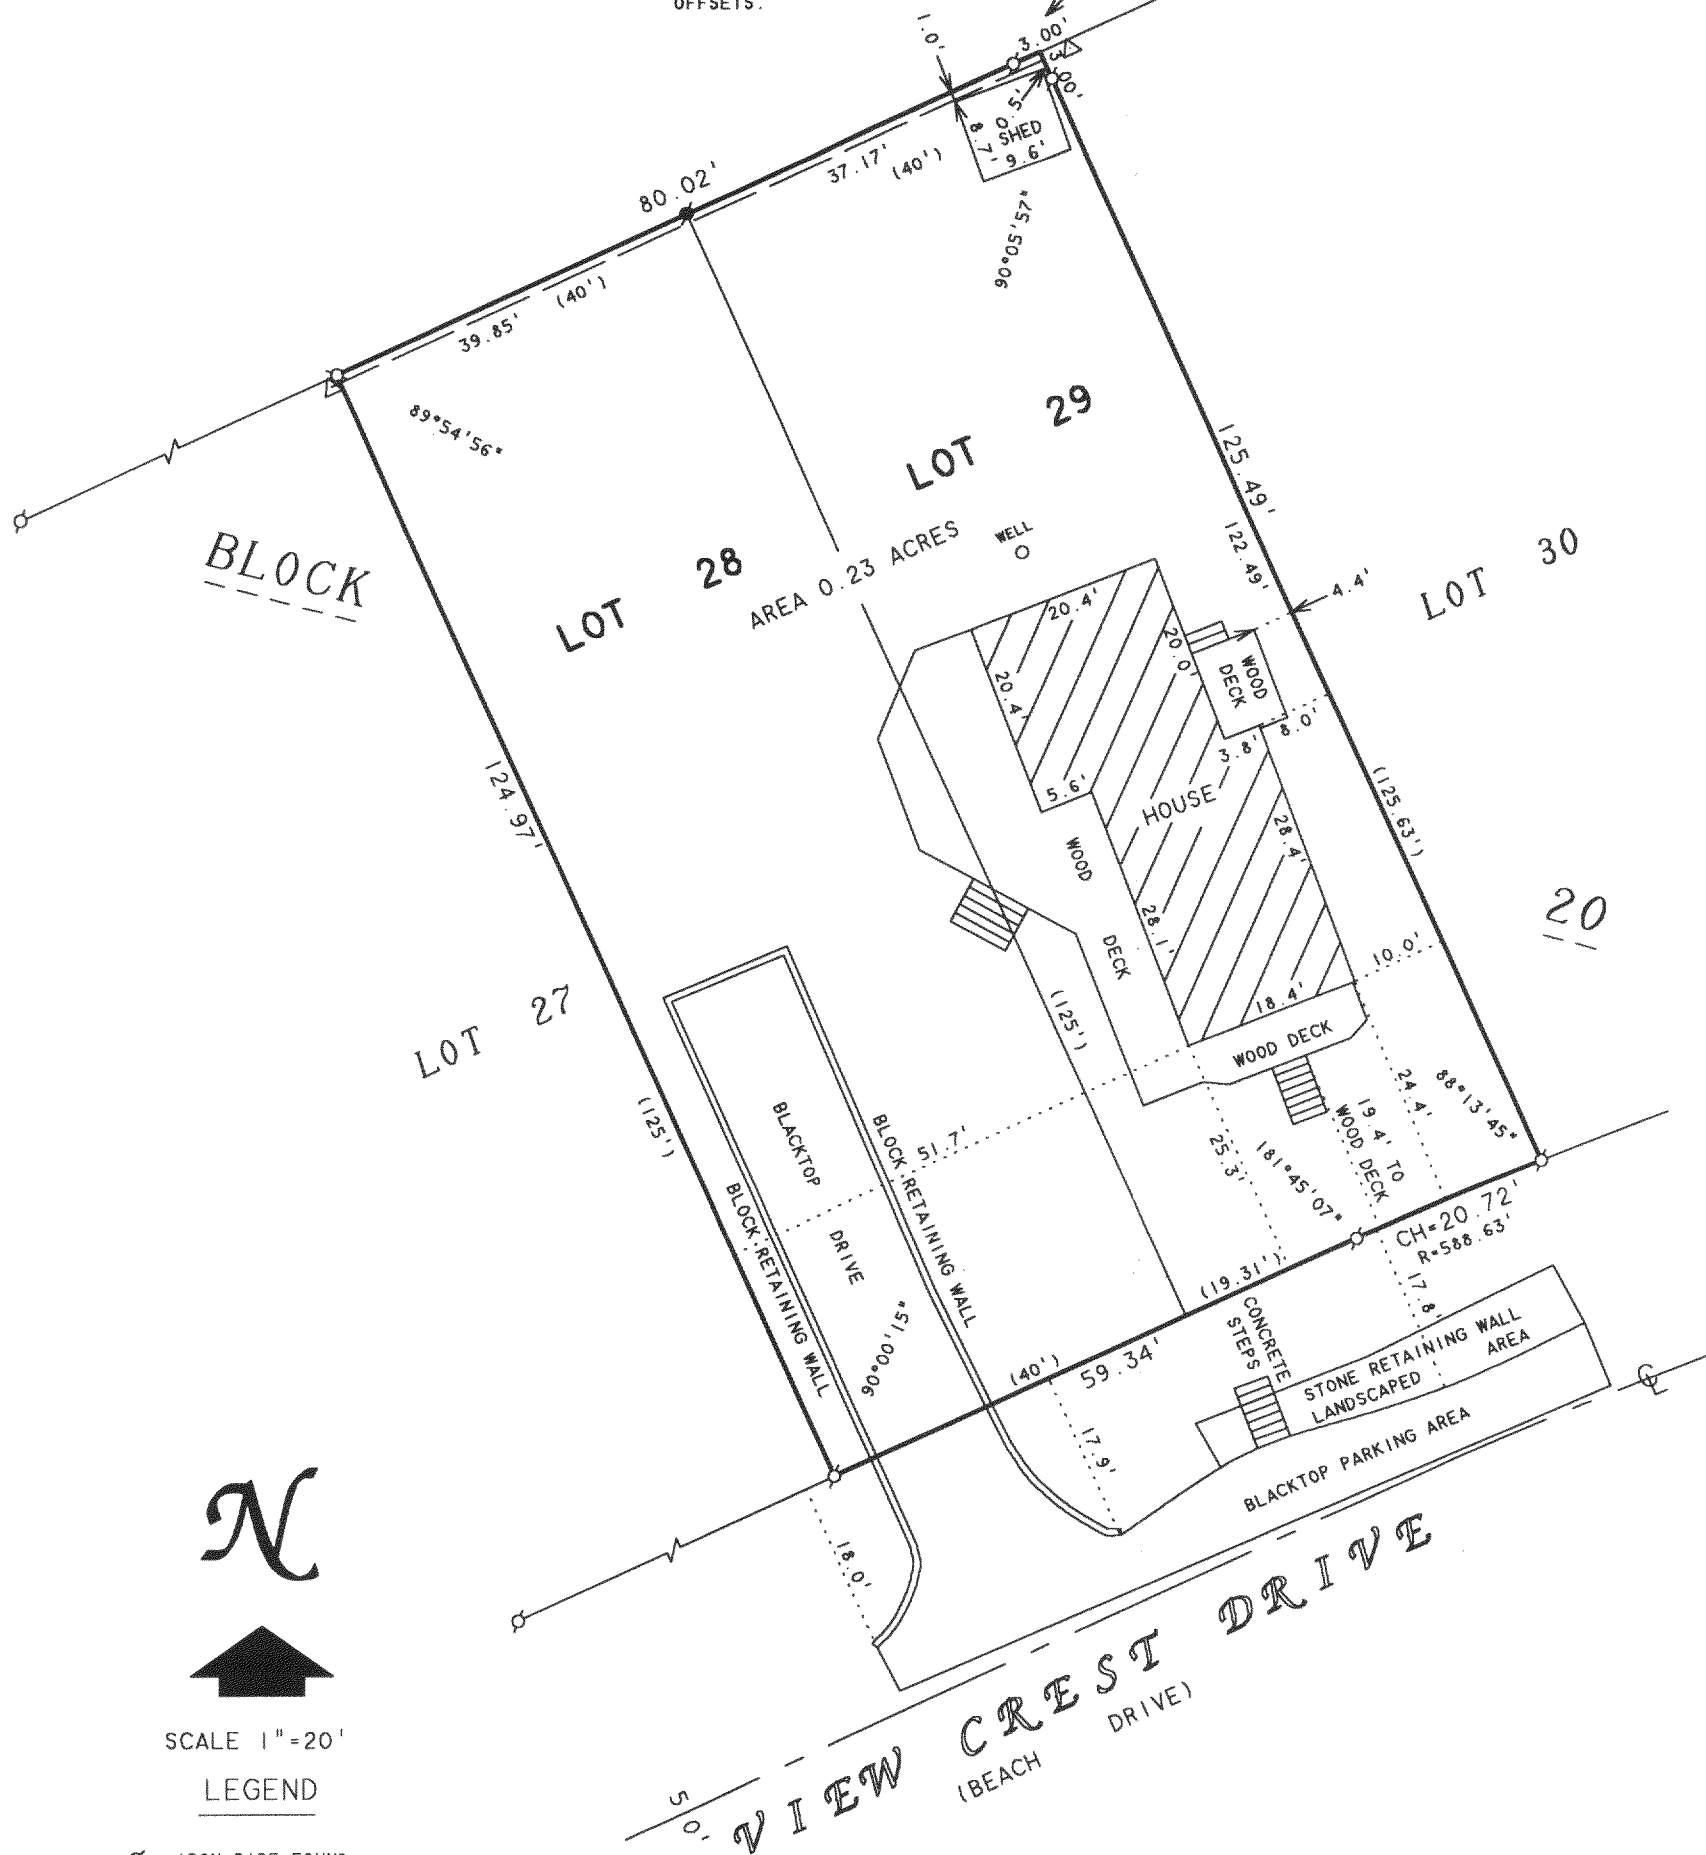

PLAT OF SURVEY OF

LOTS 28 AND 29, BLOCK 20, DELAVAN LAKE
VIEW CREST, LOCATED IN T2N, R16E, WALWORTH
COUNTY, WISCONSIN.

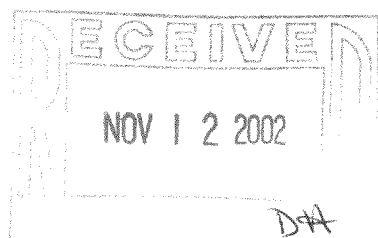

REVISED DATE: OCTOBER 16, 2002
REVISED TO SHOW CHANGES TO WOOD DECKS.

ORDERED BY: ROBERT MAHEU
2439 N. 73rd AVENUE
ELMWOOD PARK, IL 60707

I HEREBY CERTIFY THAT I HAVE SURVEYED THE ABOVE DESCRIBED PROPERTY AND THAT THE ABOVE MAP IS A TRUE REPRESENTATION THEREOF AND SHOWS THE SIZE AND LOCATION OF THE PROPERTY, ITS EXTERIOR BOUNDARIES, THE LOCATION OF ALL VISIBLE STRUCTURES AND DIMENSIONS OF ALL PRINCIPAL BUILDINGS THEREON, BOUNDARY FENCES, APPARENT EASEMENTS, ROADWAYS AND VISIBLE ENCROACHMENTS, IF ANY, TO THE BEST OF MY KNOWLEDGE AND BELIEF.

THIS SURVEY IS MADE FOR THE USE OF THE PRESENT OWNERS OF THE PROPERTY, AND ALSO THOSE WHO PURCHASE, MORTGAGE, OR GUARANTEE THE TITLE THERETO WITHIN ONE (1) YEAR FROM DATE HEREON.

David F. Abell

DAVID F. ABELL
WISCONSIN REGISTERED LAND SURVEYOR, S-1596

April 12, 2002

DATE: April 12, 2002 JOB NUMBER - 02039A
NOTE: THIS IS NOT A CERTIFIED COPY UNLESS SEALED.

V FDLV-212

216-3289