

PREPARED FOR:
BRIAN ASMUS
707 E. STREAMWOOD BLVD.
STREAMWOOD IL
60107

PLAT OF SURVEY

- OF -LOT 44 LAKE VIEW SUBDIVISION, LOCATED IN T.2.N., R.16.E., WALWORTH COUNTY, WISCONSIN. J.K. SURVEYING INC. N3705 WILLOWBEND LANE LAKE GENEVA, WI, 53147 262-248-3697

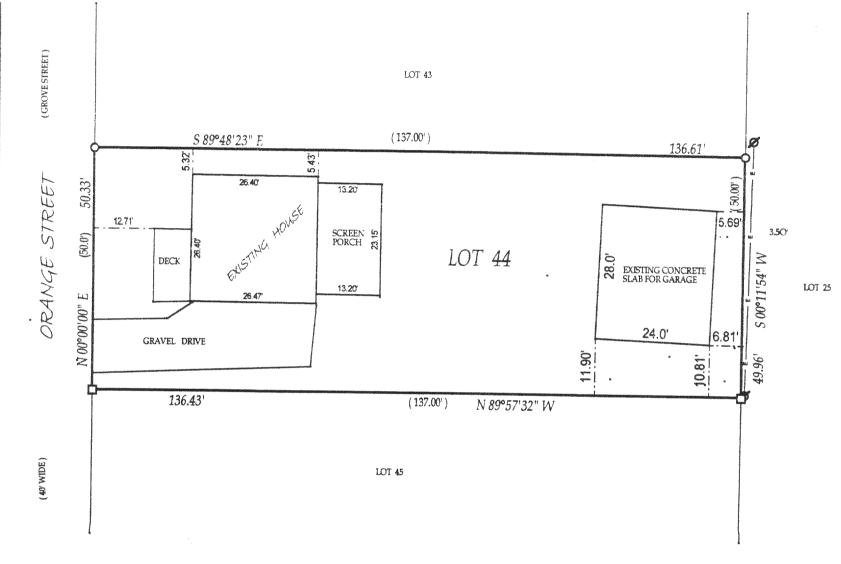

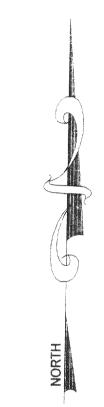

BEARINGS ARE ASSUMED



JOHN KROTT S - 2258
Wisconsin Registered Land Surveyor
(original if signed in red)

DATE OF LAST REVISION: 11th DAY OF OCTOBER 2002

COMPARE LEGAL DESCRIPTION ABOVE AND DRAWING WITH DEED. FOR BUILDING RESTRICTIONS AND EASEMENTS NOT SHOWN, REFER TO DEED, ABSTRACT SOURCES AND LOCAL MUNICIPAL CODES. NOTIFY THE SURVEYOR IMMEDIATELY OF ANY DISCREPANCY.

"I hereby certify that I have surveyed the above described property and that the above map is a true representation thereof and shows the size and location of all visible structures, apparent easements and encroachments if any."

This survey is made for the present owners of the property, and those who purchase, mortgage, or guarantee the title thereto, within one year from the date hereof. DATED THIS ____15 ___TH, DAY OF __MARCH__ 20 __02 __.

()= recorded as

= found iron bar

O = found iron pipe

= set iron pipe

= set iron bar

SCALE 1" = 20"

JOB # 02-076

TAX ID # FLAS 00039

DEC 1 7 2002

14T

FLAS-39