


GEORGE T. DUNHAM
SURVEYING & SUBDIVIDING
DELAVAN, WISCONSIN

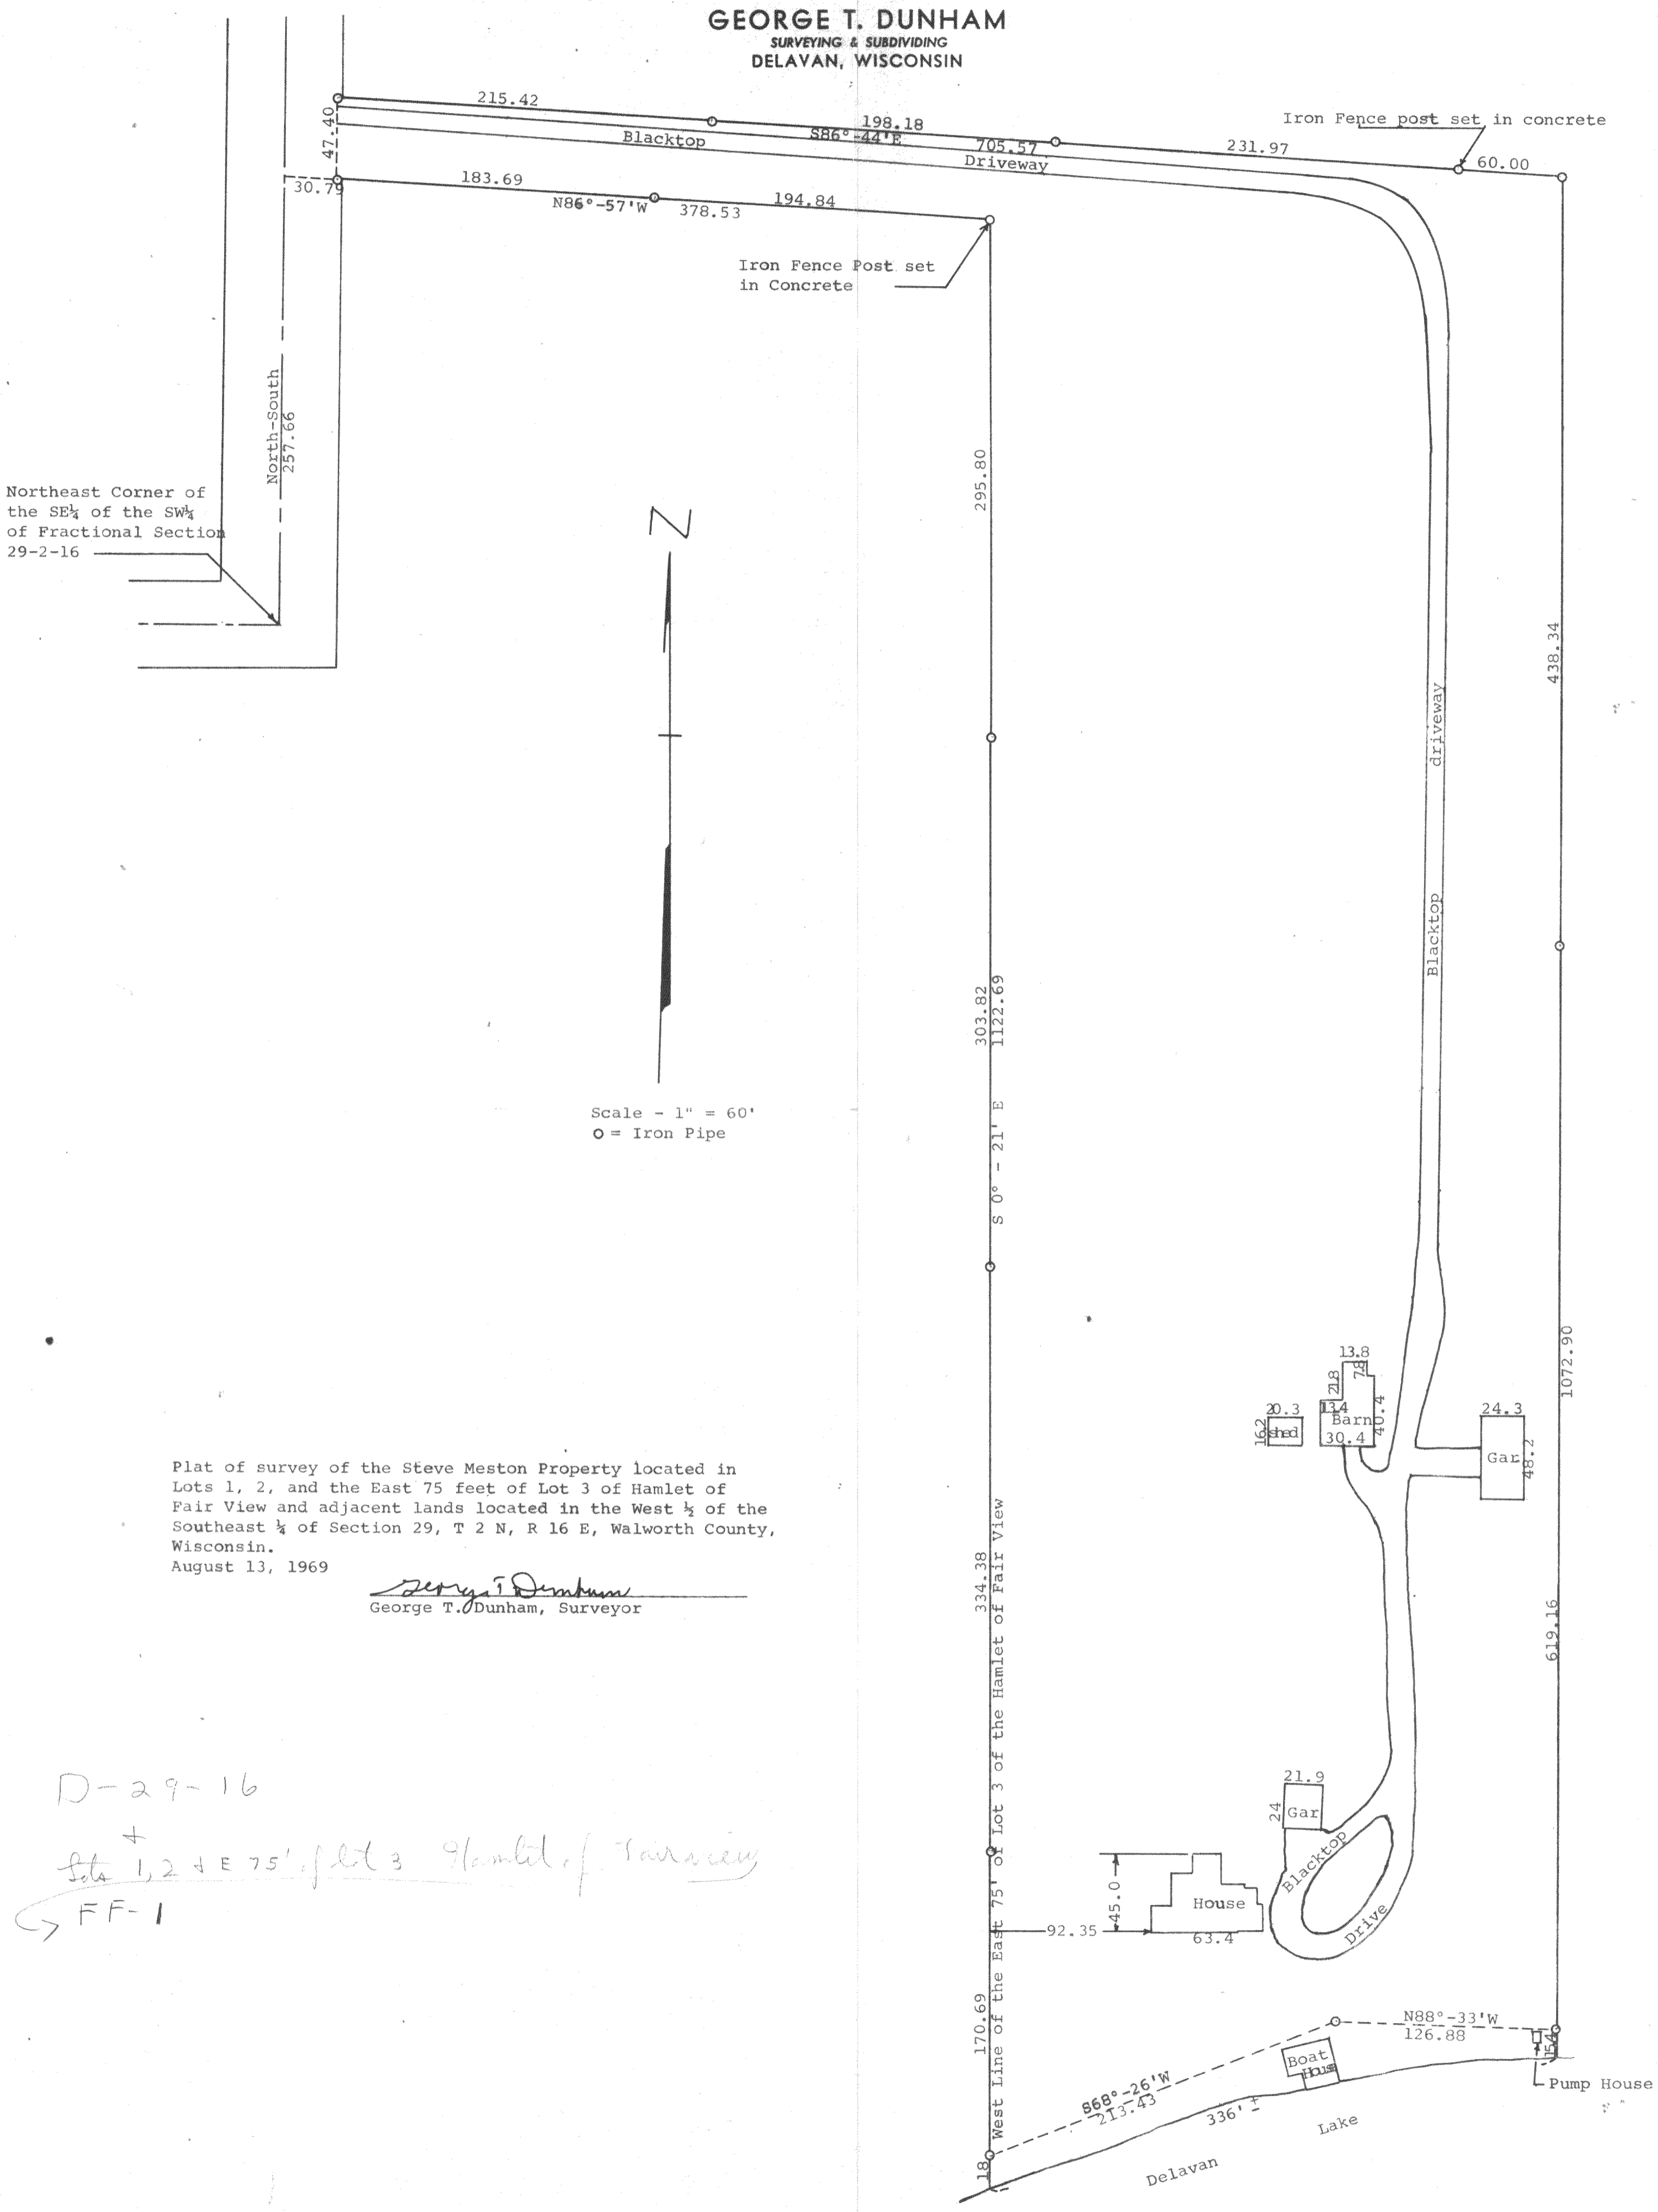

D-29-16
+
Lots 1, 2 + E 75' of Lot 3 Hamlet of Fair View
FF-1