
FARRIS, HANSEN & ASSOCIATES, INC.

ENGINEERING — ARCHITECTURE — SURVEYING
7 RIDGWAY COURT — P.O. BOX 437 — ELKHORN, WISCONSIN 53121
PHONE: (262) 723—2098 FAX: (262) 723—5886

PLAT OF SURVEY

LOT 3 AND THE WEST 1/2 OF LOT 4 OF BRATLEY SUBDIVISION AND LOTS 17 THRU 24 OF DUNCANSON'S LAKE SHORE ADDITION, LOCATED IN T2N, R16E, WALWORTH COUNTY, WISCONSIN

- WORK ORDERED BY ALLISON MIZENER
LAKE GENEVA, WI 53147
GENEVA RESORT PROPERTIES
264 CENTER STREET

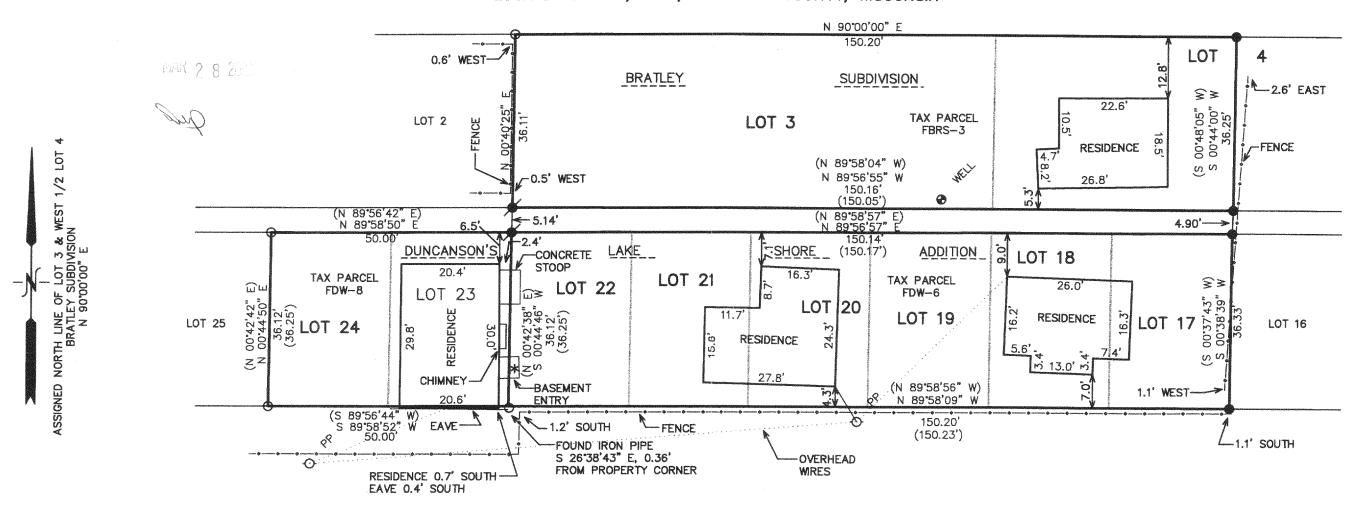

LEGEND

O = FOUND IRON PIPE STAKE

= FOUND IRON REBAR STAKE

■ SET IRON REBAR STAKE

(XXX) = RECORDED AS

FDW - 6

* WELL LOCATION SHOWN ON 1986 SURVEY BY ABELL SURVEYING & MAPPING REFERENCED TO IN WELL EASEMENT RECORDED IN VOLUME 388 ON PAGE 897 AS DOCUMENT NUMBER 140006 NOTE: COPIES OF THIS MAP TO WHICH THE FOLLOWING CERTIFICATE WILL APPLY SHOW THE SURVEYOR'S ORIGINAL SEAL AND SIGNATURE IN RED INK. COPIES BY ANY OTHER MEANS MAY HAVE ALTERATIONS WHICH DO NOT REPRESENT THE SURVEYOR'S WORK PRODUCT.

I HEREBY CERTIFY THAT THE ABOVE DESCRIBED PROPERTY HAS BEEN SURVEYED UNDER MY DIRECTION AND THAT THE ABOVE MAP IS A TRUE REPRESENTATION THEREOF AND SHOWS THE SIZE AND LOCATION OF THE PROPERTY, ITS EXTERIOR BOUNDARIES, THE LOCATION OF ALL VISIBLE STRUCTURES, AND DIMENSIONS OF ALL PRINCIPLE BUILDINGS THEREON, BOUNDARY FENCES, APPARENT EASEMENTS, ROADWAYS, AND VISIBLE ENCROACHMENTS, IF ANY. THIS SURVEY IS MADE FOR THE USE OF THE PRESENT OWNERS OF THE PROPERTY, AND ALSO THOSE WHO PURCHASE, MORTGAGE, OR GUARANTEE THE TITLE THERETO WITHIN ONE YEAR FROM THE DATE HEREOF.

10 ₅ 0	10 L	20	30	40	50 	60	70 I	80 I	90	100
	1 000 E-100 E	MAP	SCALE IN	FEET	ORIGINAL	1"	= 20'			n-reconstruction of the second

PETER S. GORDON

DATED:

PROJECT: 6226 DATE: 03/13/03 SHEET 1 OF 1