


GEORGE T. DUNHAM
SURVEYING & SUBDIVIDING
DELAVER, WISCONSIN

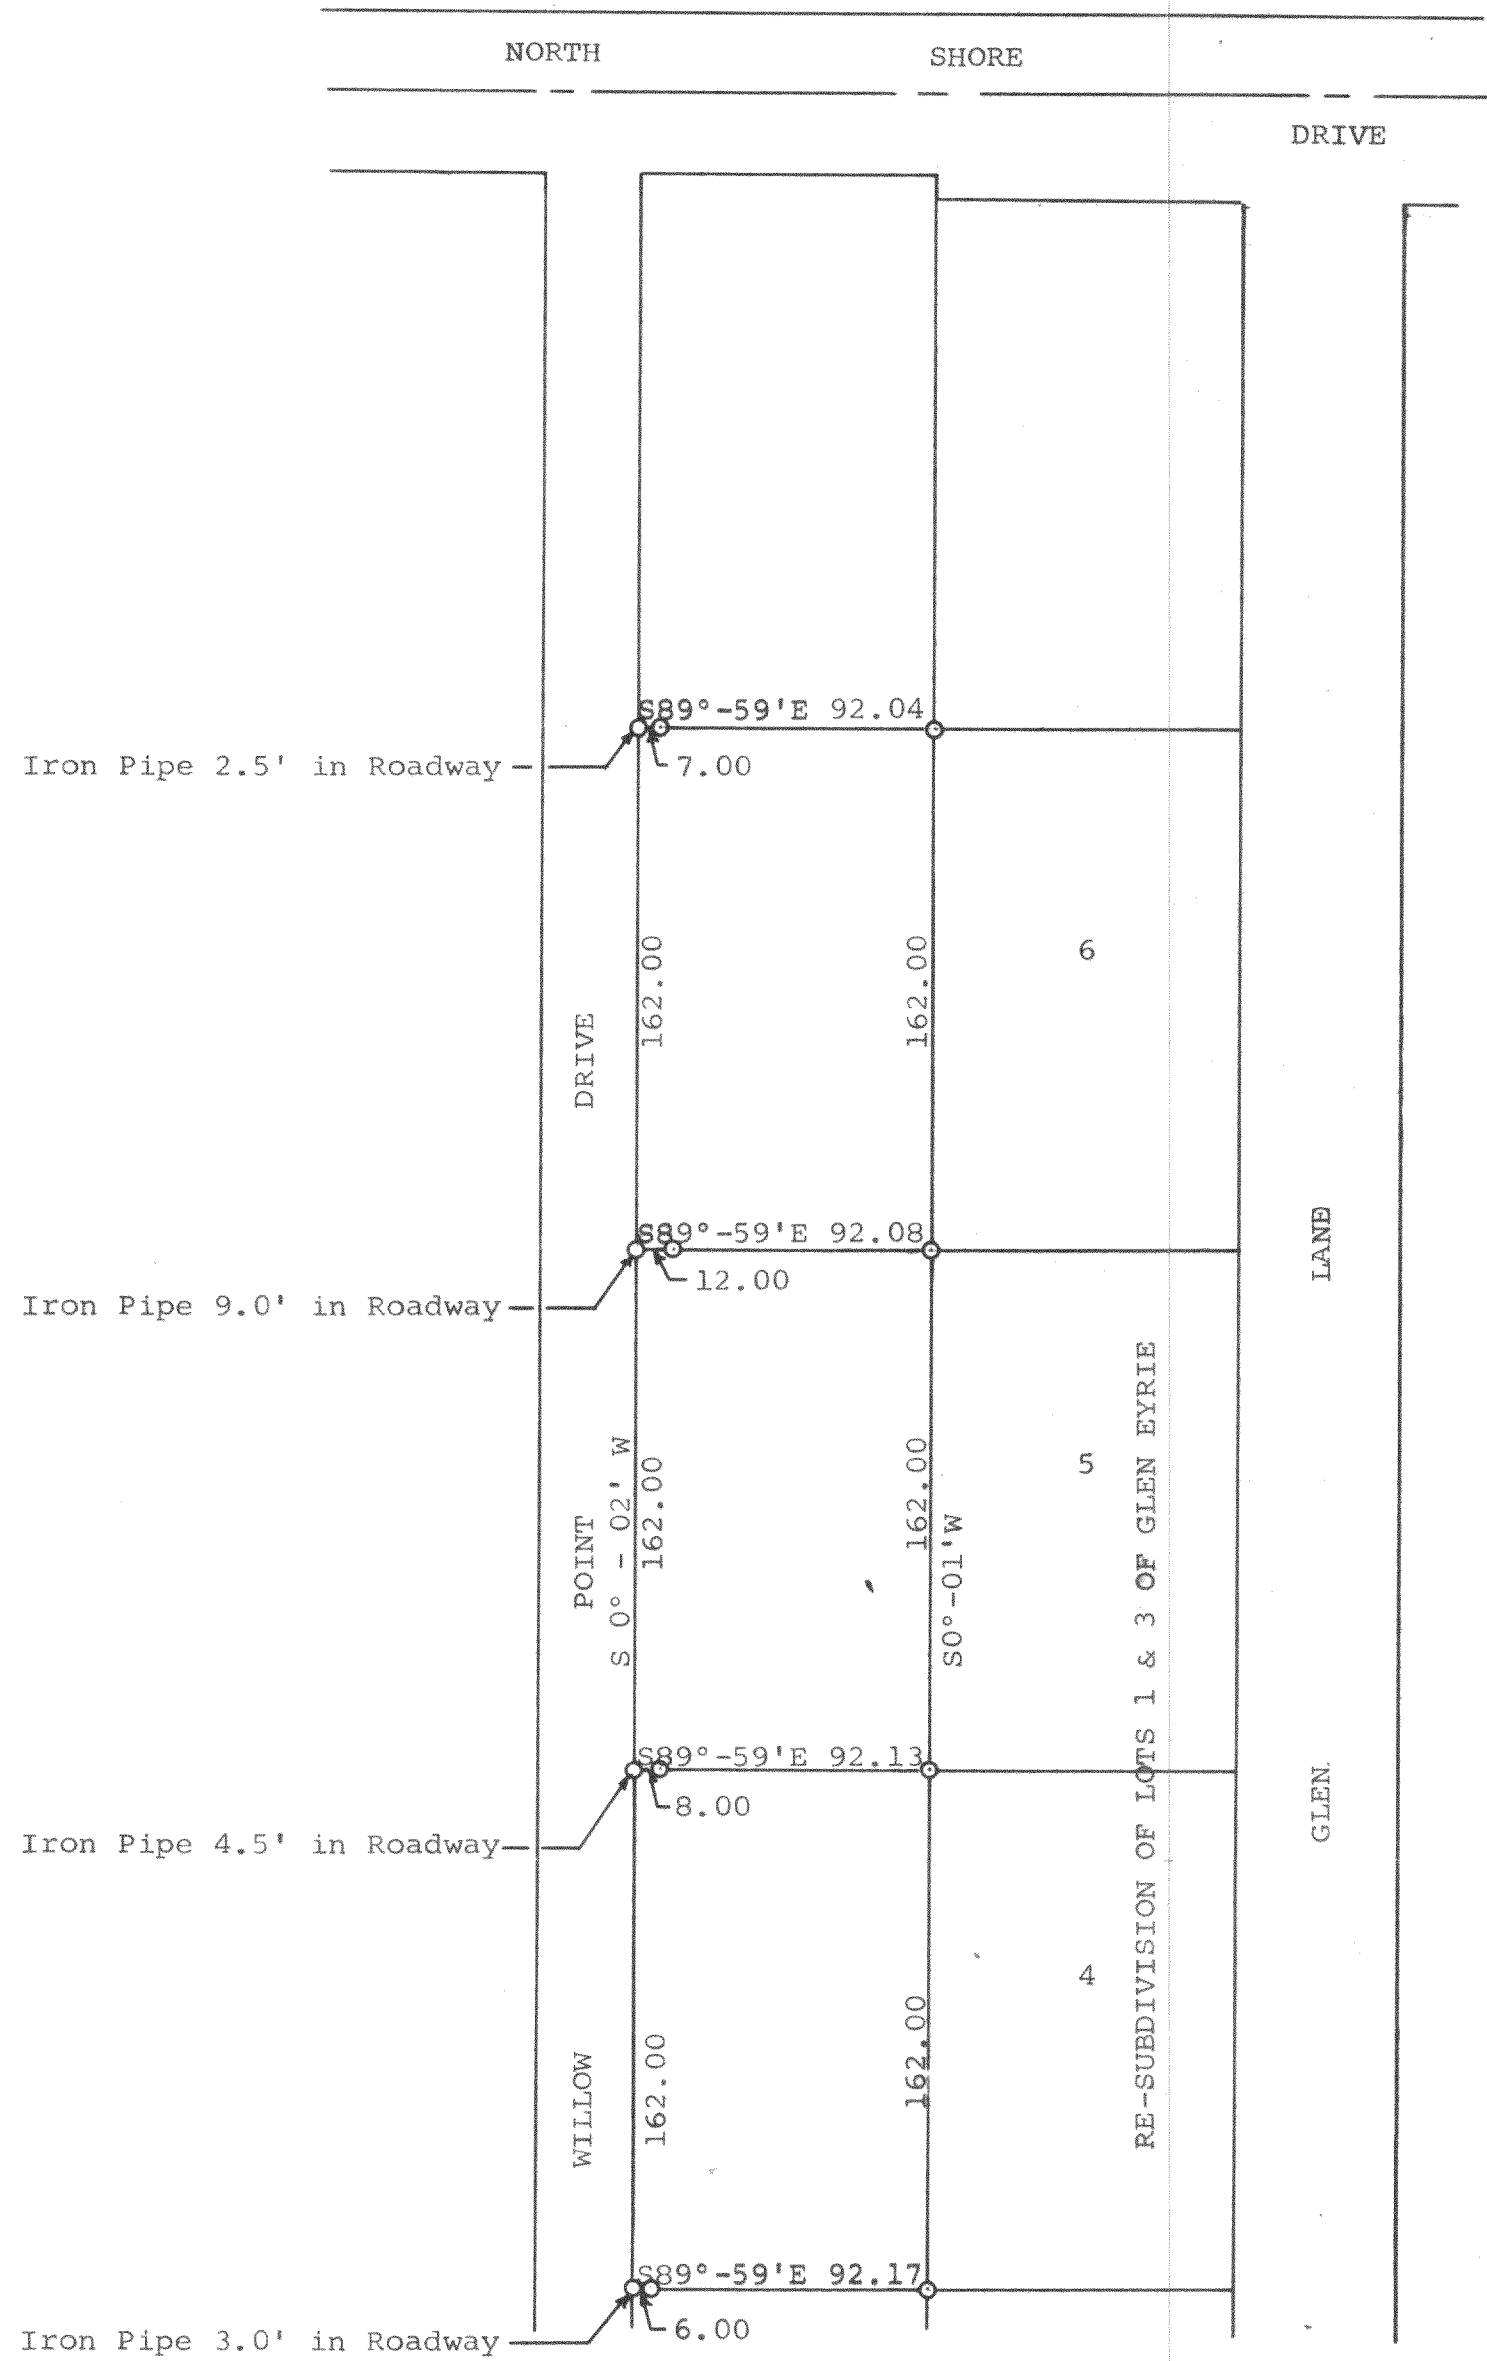

Plat of survey of several parcels of land located in the
Southeast ¼ of Section 29, T 2 N, R 16 E, Walworth County,
Wisconsin.
December 2, 1969

George T. Dunham
George T. Dunham, Surveyor

FD 21-228, 229, 230
FGE 4, 5, 6