


DUNHAM SURVEYING, S.C.
SURVEYING & SUBDIVIDING
DELAVER, WISCONSIN 53115

S.T. JAMES
AVENUE

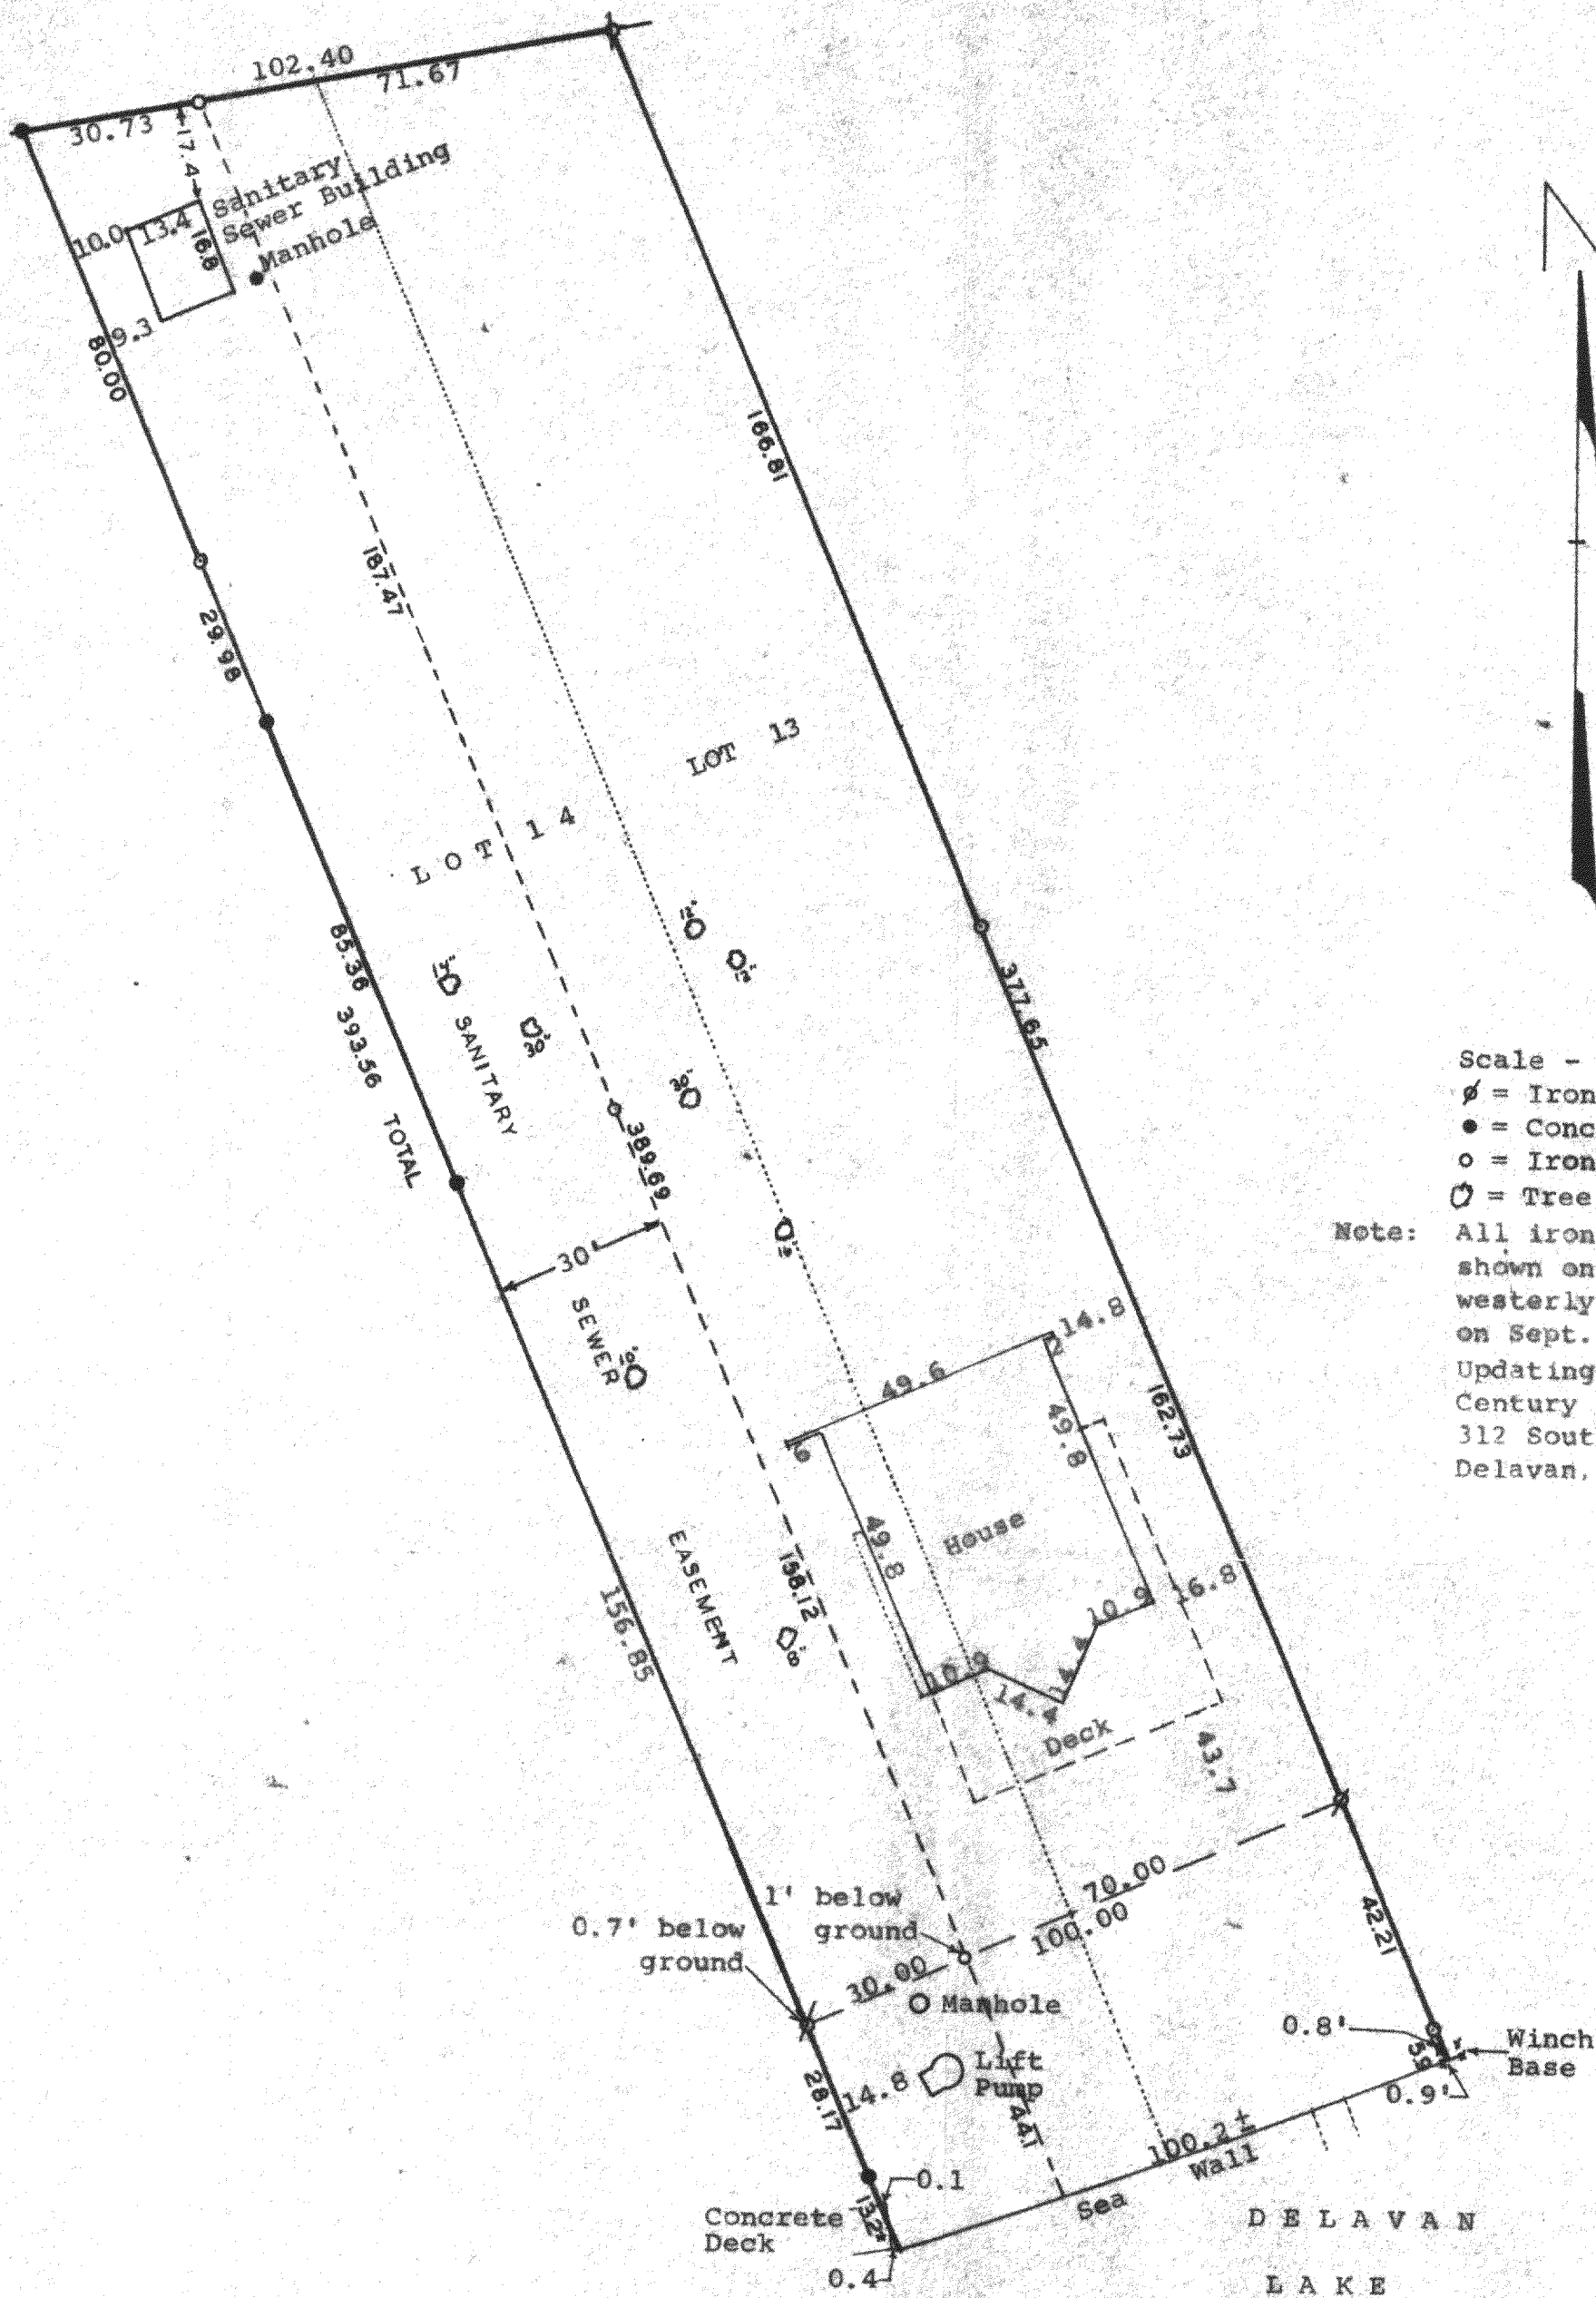

Scale - 1" = 30'

Ø = Iron Pipe Found
● = Concrete Monument Found
○ = Iron Pipe Set
○ = Tree

Note: All iron pipes and concrete monuments shown on the northeasterly and southwesterly property lines were relocated on Sept. 9, 1988. Also on October 7, 1996, relocated. Updating and recertification ordered by: Century 21, Skandia Realty 312 South 7th Street Delavan, WI 53115

STATE OF WISCONSIN)
COUNTY OF WALWORTH) SS.

I, James M. Dunham, Surveyor, certify that I have surveyed the property described as follows,

Lots 13 and 14 of St. Mary's of Delavan Lake, a subdivision located in Section 28, T 2 N, R 16 E, Walworth County, Wisconsin, subject to easements of record.

and that the above map is a true representation thereof and shows the size and location of the property, its exterior boundaries, the location of all visible structures and dimensions of all principal buildings thereon, boundary fences, apparent easements, roadways and visible encroachments, if any.

This survey is made for the use of the present owners of the property, and also those who purchase, mortgage, or guarantee the title thereto within one (1) year from date hereof.

April 1, 1981

Updated and recertified Sept. 9, 1988

George T. Dunham
George T. Dunham, Surveyor

Updated and recertified to this 7th day of October, 1996

George T. Dunham
George T. Dunham, Surveyor

James M. Dunham
James M. Dunham, Surveyor

