


SURVEYING & SUBDIVIDING
DELAN, WISCONSIN 53115

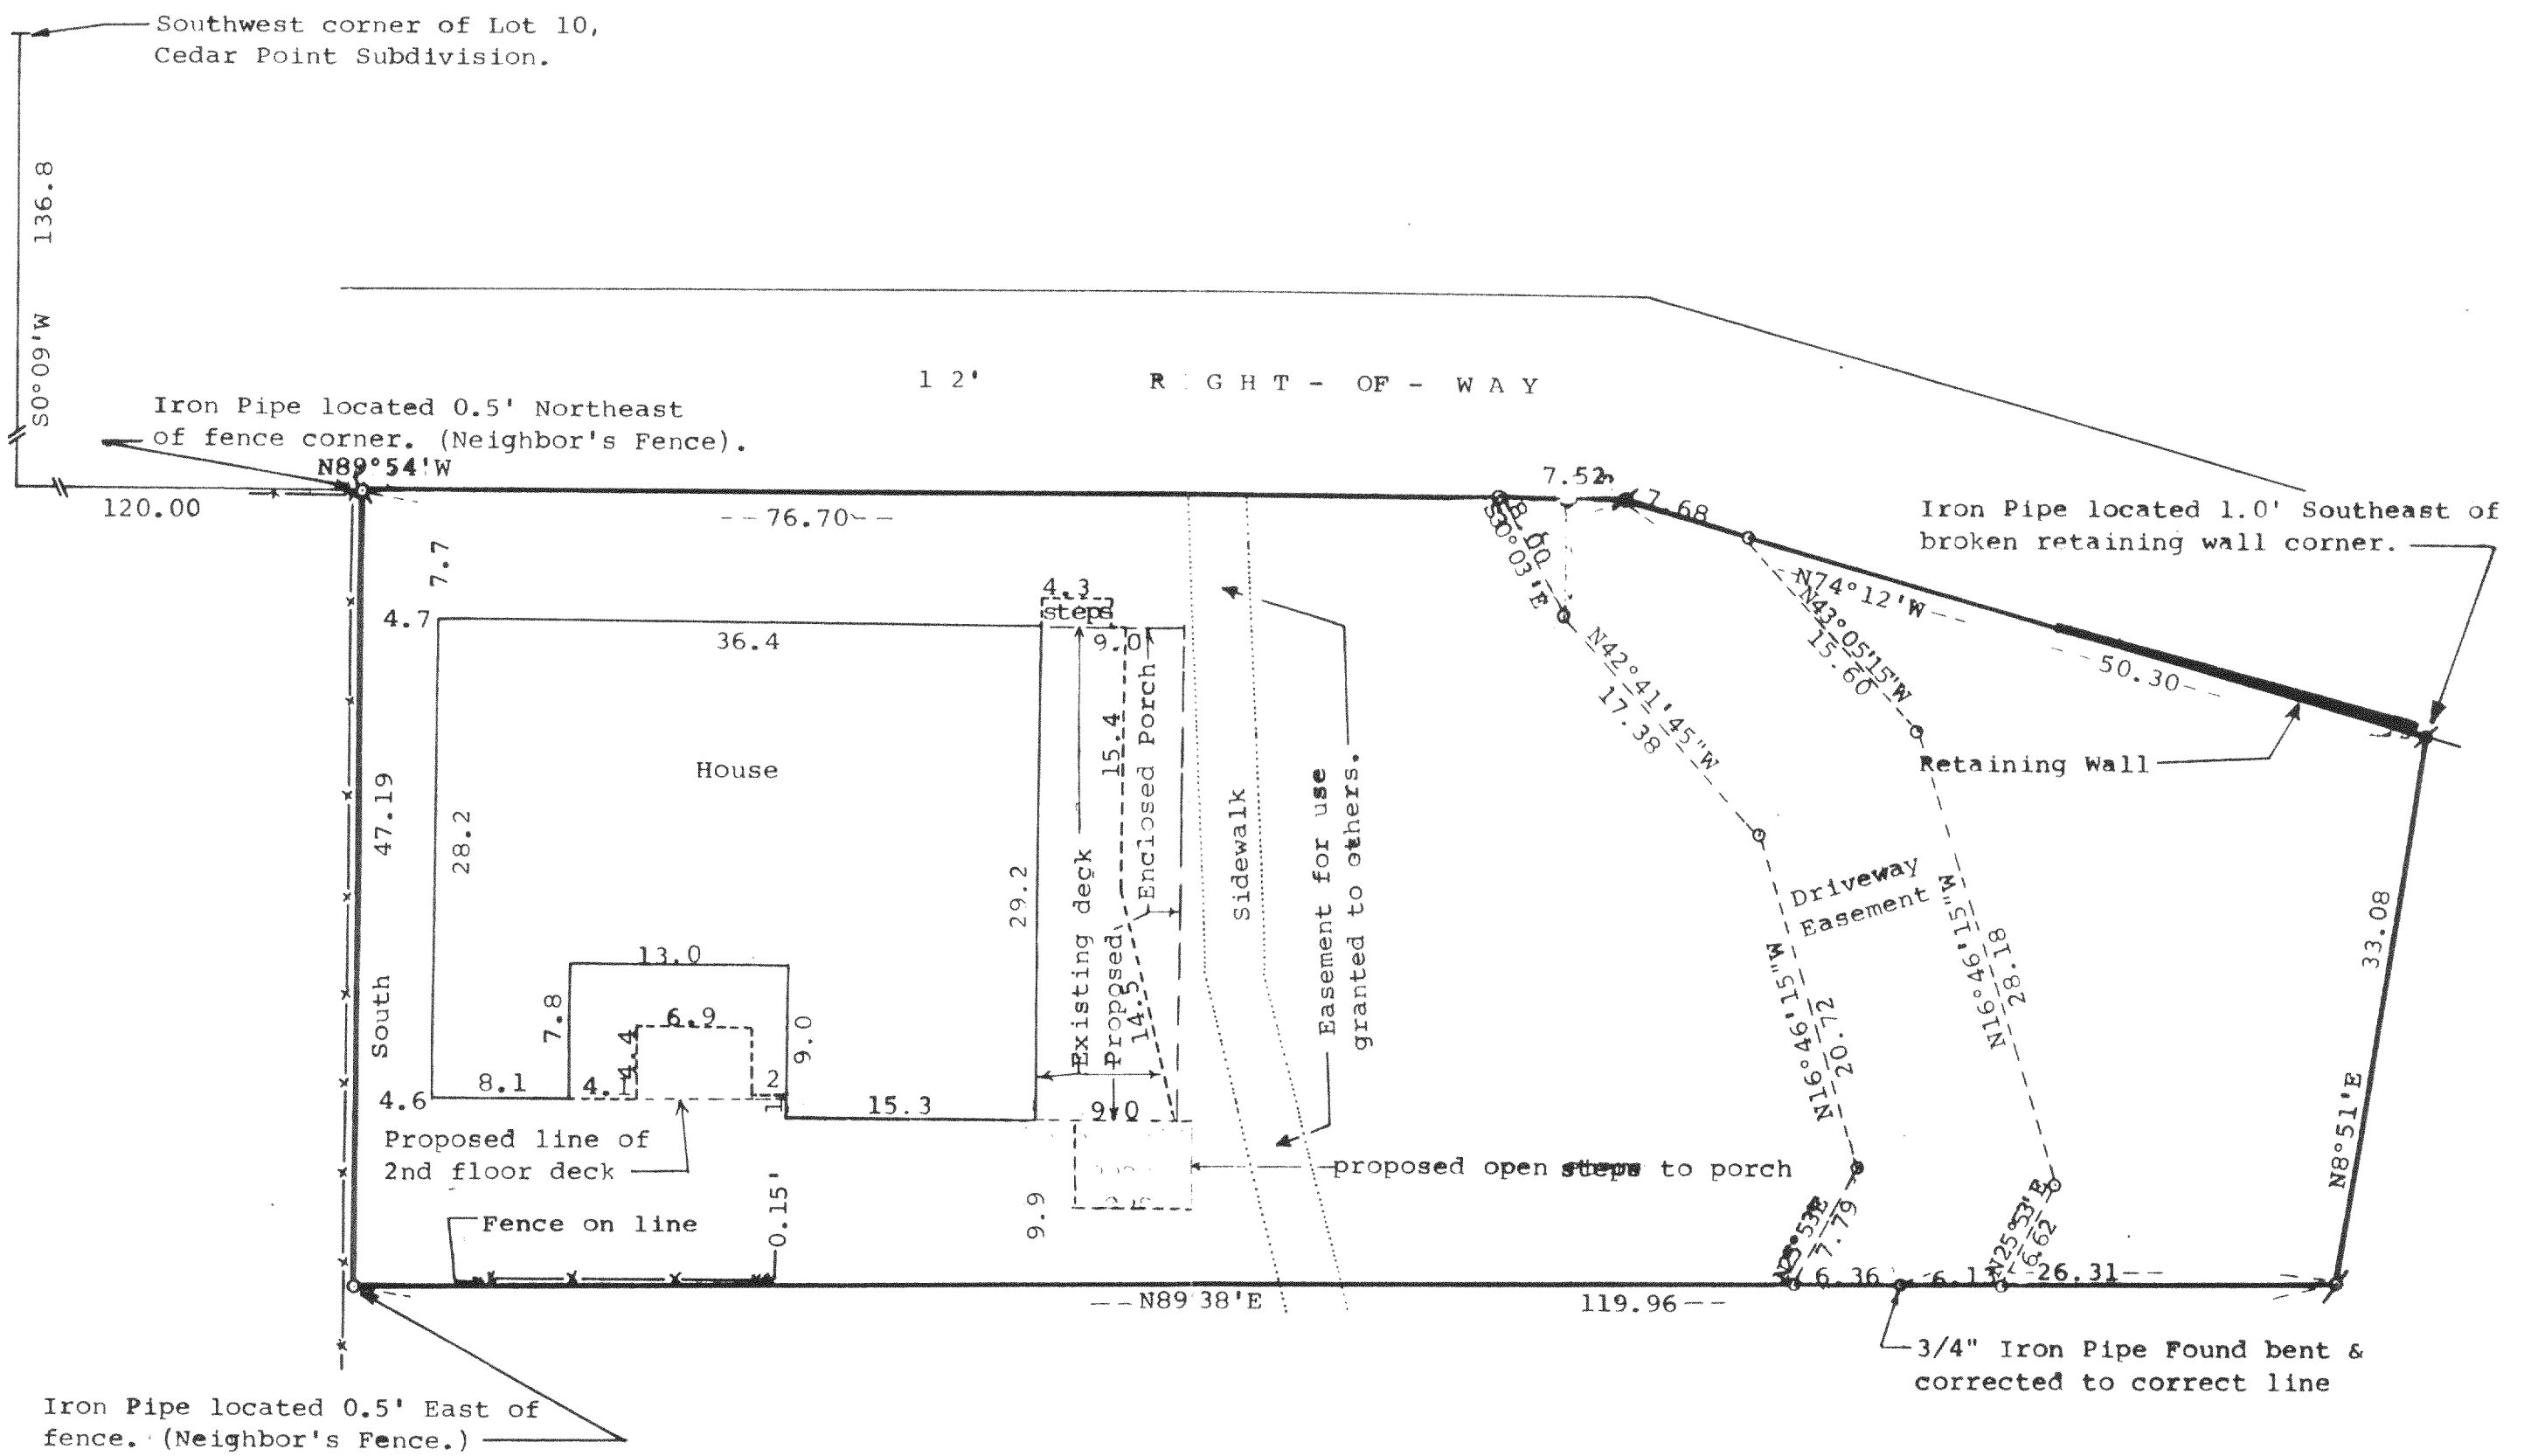

STATE OF WISCONSIN)
COUNTY OF WALWORTH) ss

I, George T. Dunham, Surveyor, certify that I have surveyed the property described as follows,

Part of Lot 9 of Cedar Point Subdivision, which subdivision is located in the Northeast Fractional quarter ($\frac{1}{4}$) of Section 28, T 2 N, R 16 E, Walworth County, Wisconsin, described as follows: Commencing at the southwest corner of Lot 10, of said subdivision; thence S0°09'W, along the west line of said Lot 9, 136.8 feet; thence S89°54'E, 120.00 feet to the place of beginning; thence South, 47.19 feet; thence N89°38'E, 119.96 feet; thence N8°51'E, 33.08 feet; thence N74°12'W, 50.30 feet; thence N89°54'W, 76.70 feet to the place of beginning, subject to and including any easements of record, and that the map shown above is a true representation thereof and shows the size and location of the property, its exterior boundaries, the location of all visible structures and dimensions of all principal buildings thereon, boundary fences, apparent easements, roadways and visible encroachments, if any, and that I have surveyed the property hereon described according to the official records to the best of my knowledge and belief.

July 27, 1984.
Certified to be correct
this 4th day of August, 1988.
Recertified to this 15th day of
March, 1990

Recertified to this 19th day of May, 2002

Description of driveway easement:

A part of said Lot 9 of Cedar Point Subdivision, described as follows: Commencing at the southwest corner of Lot 10, of said subdivision; thence S0°09'W, along the west line of said Lot 9, 136.8 feet; thence SR9°54'E 189.18 feet to the place of beginning; thence S30°03'E 8.00 feet; thence S42°41'45"E 17.31 feet; thence S16°46'15"E 20.72 feet; thence S25°53'W 7.79 feet to the south line of the grantors land thence N89°38'E along said south line 12.49 feet; thence N25°53'E 6.62 feet; thence N16°46'15"W 28.18 feet; thence N43°05'15"W 15.60 feet to the south line of the 12' wide road right of way; thence N74°12'W along said south line 7.68 feet; thence N89°54'W along said south line 7.52 feet to the place of beginning.

Certified to this 29th day of May, 2002

Revised May 31, 2002

Revised Jan. 27, 2003 to show
Proposed location of enclosed
porch and line of 2nd floor deck

George T. Dunham
George T. Dunham, Surveyor

George T. Dunham
George T. Dunham, Surveyor

Scale - 1" = 10'

$\phi = 1\frac{1}{2}"$ Dia. Iron Pipe Found

Q = 1 1/4" Dia. Iron Pipe Found

$\phi = 3/4"$ Dia. Iron Pipe Found

O = $\frac{1}{2}$ " Dia. Iron Pipe Found

—A— = Fence

1/2" = 1 1/2" x 24" Iron Pipe Set

Note: Bearings are those of record.

Survey Ordered By: J. Edward Clair
(1984) Attorney At Law

617 E. Walworth Ave.
Delavan, Wisconsin

(1989) : Riemer Law Office
601 East Walworth Avenue
Delavan, WI 53115

(1990) Pam King
6348 Forestview Drive
Oak Forest, IL 60452

(2002) Dennis King
6348 Forestview Drive
Oak Forest, IL 60452

(1/27/03) Andy Devine, 6521 W. Charleston Ave., Oak Forest, IL 60452

FC-9E

216-3424

216 865