


PLAT OF SURVEY  
LOT 16, COUNTRY VIEW SUBDIVISION, being a part of the  
Southwest ¼ of Section 23, Town 2 North, Range 16 East, Town  
of Delavan, Walworth County, Wisconsin.

Surveyed for: Bielinski Bros. Builders/William and Therese Wagner

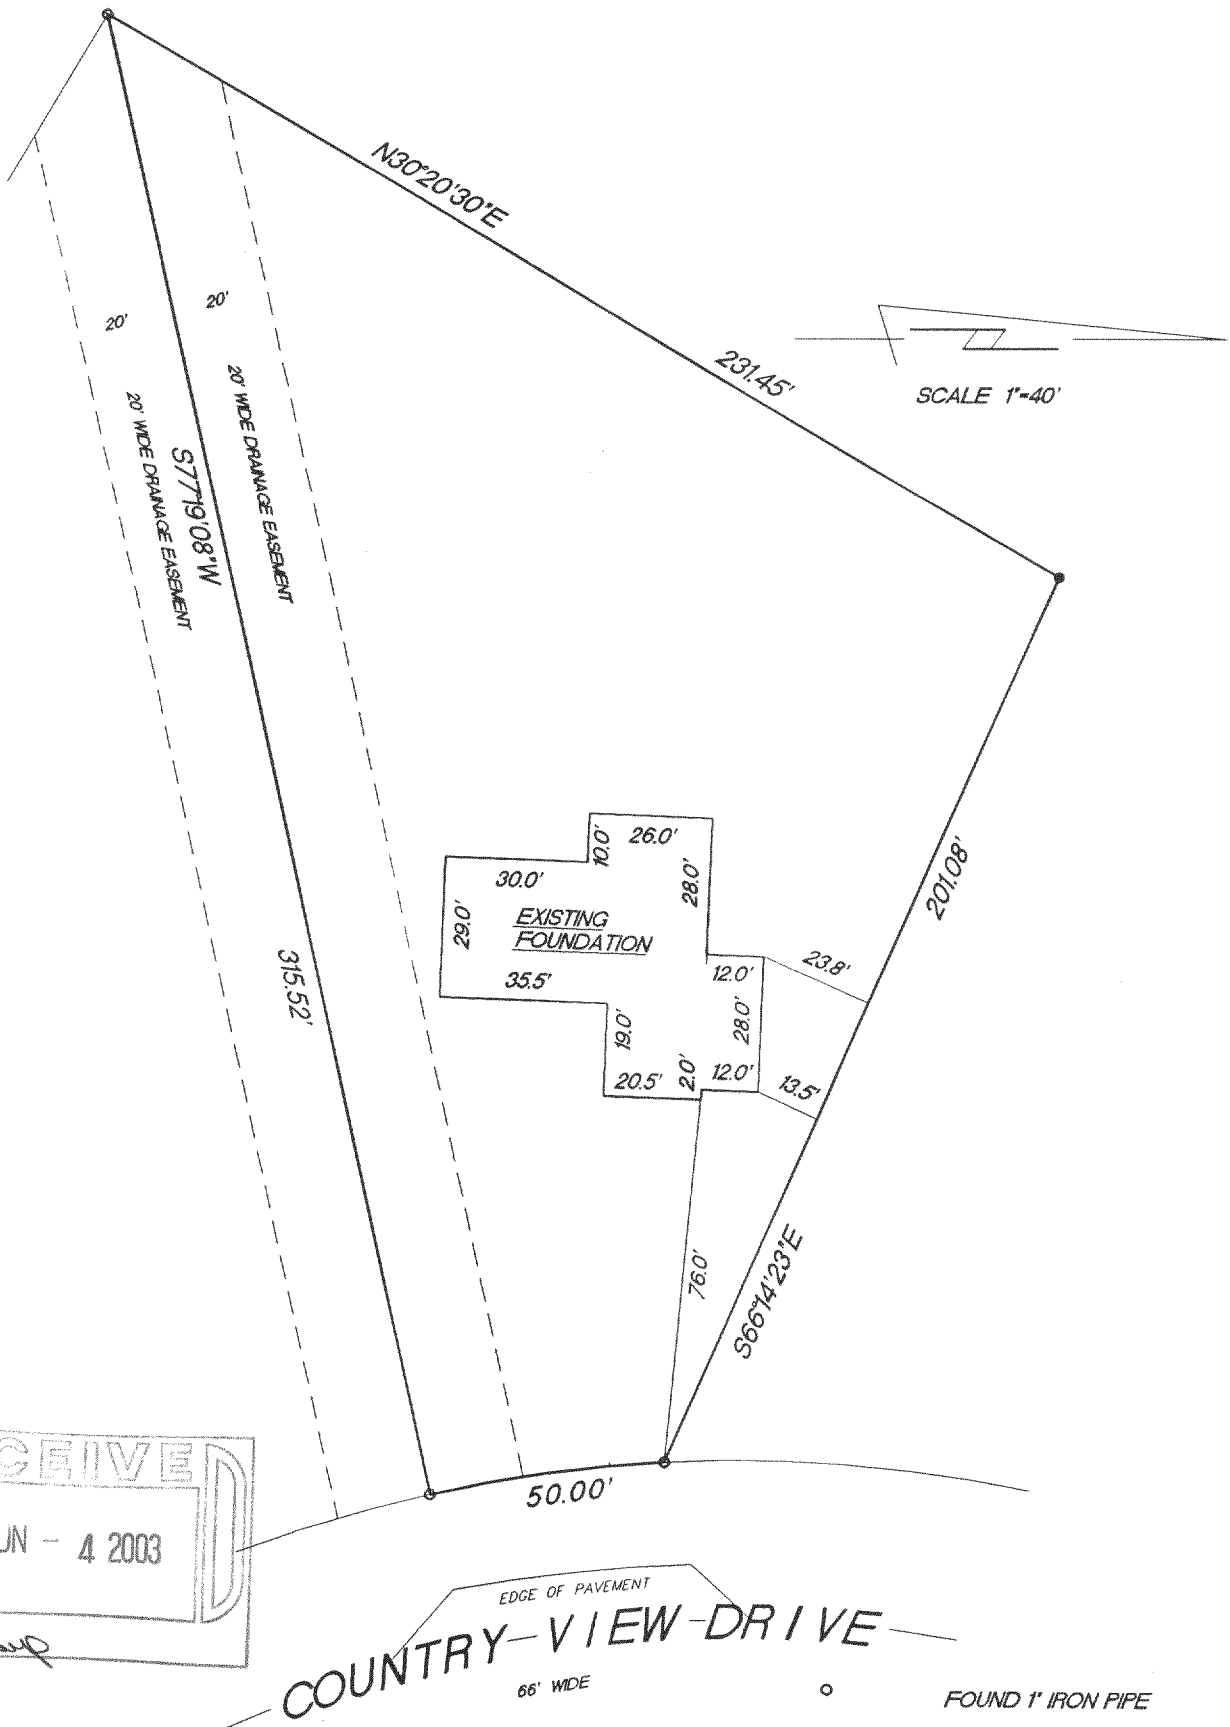


RADIUS	LENGTH	CHORD	BEARING	DELTA
300.00'	50.00'	49.95'	S07°54'24"E	09°33'00"

"I hereby certify that I have surveyed the above described property and that the above map is a true representation thereof and shows the size and location of the property, its exterior boundaries, the location of all visible structures and dimension of all principal buildings thereon, boundary fences, apparent easements, roadways and encroachments if any."

"This survey is made for the use of the present owners of the property, and also those who purchase, mortgage or guarantee the title thereto within one year from date hereof."

KETTLE MORAINES SURVEYING INC.  
W356 S9050 Godfrey Lane  
Eagle Wisconsin 53119  
P.O. Box 357  
(262) 594-3484  
Terrance E. Pisarek R.L.S.

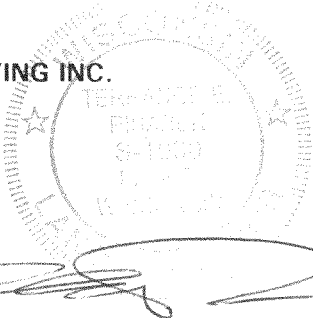

THIS IS NOT AN ORIGINAL SURVEY UNLESS THE SEAL IS RED.

REV. 5/22/03  
3/12/03

DATE

TEP/DW  
FIELD WORK BY

TEP  
DRAWN BY

03007  
JOB NUMBER

FCV-16

216-3475